

Jackson
 P 361
 8-10-73

MISSISSIPPI
 BOARD OF WATER COMMISSIONERS
 416 North State Street
 Jackson, Mississippi 39201

CODED

WATER WELL DRILLERS LOG

COAST WATER WELL SERVICE

8/10 1973
 date well completed

firm name

Jackson
 county well located

LANDOWNER: H. B. Wallace
1909 Meadowbrook Dr
Pascagoula, Ms.
 (mailing address)
 WELL LOCATION:
 sec. 9 T. 8 N. R. 6 W.
in Nauticus
 (distance) miles (direction) of (nearest town)

description of formations encountered	from	to
<u>clay</u>	<u>0</u>	<u>21</u>
<u>fine sand</u>	<u>21</u>	<u>26</u>
<u>Rock</u>	<u>26</u>	<u>27</u>
<u>coarse sand</u>	<u>27</u>	<u>80</u>

WELL PURPOSE: Nursery
 (home, irrigation, municipal, industrial)

WELL COMPLETION DATA:
 (1) diameter (inches) 2"
 (2) total depth (feet) 80
 (3) static water level (feet) 8 below above top of ground.
 (4) casing P.V.C., 70',
 (material) (depth)
2" if telescope see back.
 (size)
 (5) screen 10', 70'
 (length) (depth to top)
2", P.V.C.
 (size) (material)
 (6) pump 1/2, 8
 (HP) (yield gpm)
elec.
 (type power)
 (7) electric log NO
 (yes or no)
 (organization running log)
 (8) how well bottom plugged
B.W. Value

CODED


SEP 27 1973

MISS. HU. U.
 WATER COM.

DRILLERS REMARKS:

If well telescopes please sketch and show depths.

GROUND LEVEL

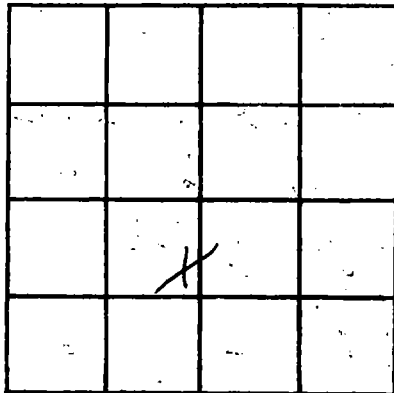

SECTION 9

Please indicate well location X.

ADDITIONAL INFORMATION

If more than one screen, show locations of each on sketch.