

Jackson
P 362
7-9-73

MISSISSIPPI
BOARD OF WATER COMMISSIONERS
416 North State Street
Jackson, Mississippi 39201

WATER WELL DRILLERS LOG

CODED

7/9 1973 date well completed
COAST WATER WELL SERVICE firm name
Jackson county well located

LANDOWNER: E. S. Jeff
P.O. Box 154
Nautie, Mo.
(mailing address)

description of formations encountered	from	to
top soil w/ white clay	0	40
med. to coarse sand	40	120
Blue clay	120	215
Med - med - to coarse	215	315
Blue clay	315	395
med fine to med	395	420

WELL LOCATION:
sec. 8 T. 8 N. R. 6 E
in Nautie
(distance) miles (direction) of (nearest town)

WELL PURPOSE: Home
(home, irrigation, municipal, industrial)

- WELL COMPLETION DATA:
- (1) diameter (inches) 2"
 - (2) total depth (feet) 420'
 - (3) static water level (feet) 21' below above top of ground
 - (4) casing galv. 410'
(material) (depth)
2" if telescope see back.
(size)
 - (5) screen 10' 410'
(length) (depth to top)
2" stainless steel
(size) (material)
 - (6) pump 1/2 8
(HP) (yield gpm)
elec.
(type power)
 - (7) electric log NO
(yes or no)
- (organization running log) _____
- (8) how well bottom plugged B-W Valve

CODED


SEP 21 1973

MISS. BD. OF
WATER COM.

DRILLERS REMARKS:

If well telescopes please sketch and show depths.

GROUND LEVEL

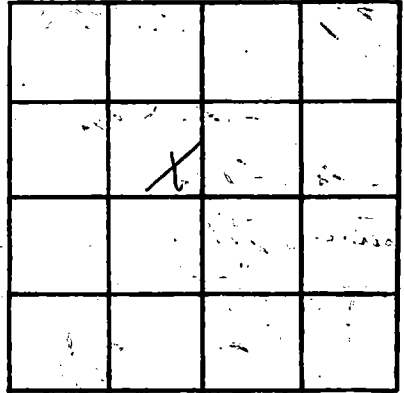

SECTION 8

Please indicate well location X.

ADDITIONAL INFORMATION

If more than one screen,
show locations of each on sketch.