

JACKSON
P 363
9-29-73

MISSISSIPPI
BOARD OF WATER COMMISSIONERS
416 North State Street
Jackson, Mississippi 39201

CODED

WATER WELL DRILLERS LOG

COAST WATER WELL SERVICE

Jackson

9/29 1973
date well completed


firm name

county well located

LANDOWNER:	description of formations encountered	from	to
Margaret Luster Rt. 2			
Gautier, Ms. (mailing address)	Blue clay	21	41
WELL LOCATION: sec. 8 T. 7 N R. 6 E In Gautier, Ms. (distance) miles (direction) of (nearest town)	Coarse sand	41	68
WELL PURPOSE: <u>Home</u> (home, irrigation, municipal, industrial)			
WELL COMPLETION DATA:			
(1) diameter (inches) <u>2"</u>			
(2) total depth (feet) <u>68'</u>			
(3) static water level (feet) <u>24'</u> ^{below} above top of ground.			
(4) casing <u>galv.</u> <u>63'</u> (material) (depth)			
<u>2"</u> (size) If telescope see back.			
(5) screen <u>5'</u> <u>63'</u> (length) (depth to top)			
<u>2"</u> <u>stainless steel</u> (size) (material)			
(6) pump <u>1/2</u> <u>8</u> (HP) (yield gpm)			
<u>elec.</u> (type power)			
(7) electric log <u>NO</u> (yes or no)			
(organization running log)			
(8) how well bottom plugged <u>Backward valve</u>			
DRILLERS REMARKS:			

If well telescopes please sketch and show depths.

GROUND LEVEL

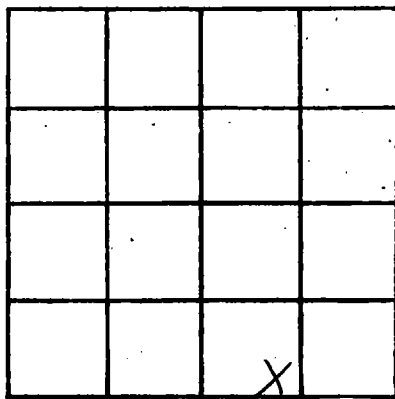

SECTION 8

Please indicate well location X.

ADDITIONAL INFORMATION

If more than one screen, show locations of each on sketch.