

JACKSON
P 364
11-24-73

MISSISSIPPI
BOARD OF WATER COMMISSIONERS
416 North State Street
Jackson, Mississippi 39201

CODED

WATER WELL DRILLERS LOG
COAST WATER WELL SERVICE

11/24 1973
date well completed

firm name

Jackson
county well located

LANDOWNER: Roberto Homes
P.O. Box 266
Escatawpa, Ms
(mailing address)

description of formations encountered	from	to
top soil	0	5
gray clay	5	10
coarse sand + gravel	10	143
Blue clay	143	184
fine sand	184	246
coarse sand	246	285

WELL LOCATION:
sec. 8 T 8 R 6 W
In Aubree, Mo.
(distance) miles (direction) of (nearest town)

WELL PURPOSE: home
(home, irrigation, municipal, industrial)

WELL COMPLETION DATA:
(1) diameter (inches) 2"
(2) total depth (feet) 285'
(3) static water level (feet) 15 below above top of ground.
(4) casing P.V.C., 275'
(material) (depth)
2" if telescope see back.
(size) 10' 275'
(5) screen 275' 10'
(length) (depth to top)
2" P.V.C.
(size) (material)
(6) pump 1 10
(HP) (yield gpm)
elec.
(type power)
(7) electric log NO
(yes or no)
(organization running log)

(8) how well bottom plugged
backwash valve


DRILLERS REMARKS:

7 1073

MISS. BOARD OF WATER COMMISSIONERS

If well telescopes please sketch and show depths.

GROUND LEVEL

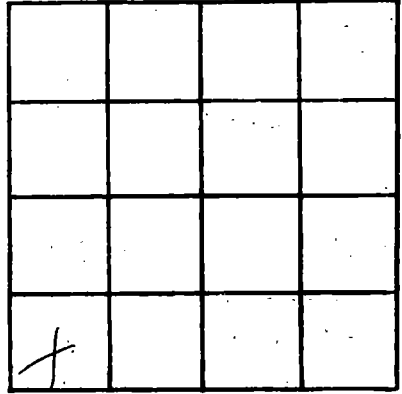

SECTION 4

Please indicate well location X.

ADDITIONAL INFORMATION

If more than one screen, show locations of each on sketch.