

**JACKSON**  
**P 365**  
**11-14-73**

MISSISSIPPI  
 BOARD OF WATER COMMISSIONERS  
 416 North State Street  
 Jackson, Mississippi 39201

**CODED**


**WATER WELL DRILLERS LOG**

11/14 1973 **COAST WATER WELL SERVICE** Jackson  
 date well completed firm name county well located

LANDOWNER: <u>Jacob Thomas</u>	description of formations encountered	from	to
<u>Rt. 2</u> <u>Lautier, Ms</u> (mailing address)			
	<u>top soil</u>	<u>0</u>	<u>6</u>
	<u>gray clay</u>	<u>6</u>	<u>15</u>
WELL LOCATION: sec. <u>3</u> T. <u>8<sup>s</sup></u> R. <u>6<sup>w</sup></u> <u>In Lautier, Mo.</u> (distance) miles (direction) of (nearest town)	<u>coarse sand</u>	<u>15</u>	<u>112</u>
	<u>blue clay</u>	<u>112</u>	<u>122</u>
	<u>coarse sand</u>	<u>122</u>	<u>146</u>
WELL PURPOSE: <u>apt. building</u> (home, irrigation, municipal, industrial)	<u>blue clay</u>	<u>146</u>	<u>193</u>
WELL COMPLETION DATA:	<u>fine sand</u>	<u>193</u>	<u>258</u>
(1) diameter (inches) <u>2"</u>	<u>coarse sand</u>	<u>258</u>	<u>285</u>
(2) total depth (feet) <u>285'</u>			
(3) static water level (feet) <u>12</u> below above top of ground.			
(4) casing <u>P.V.C.</u> , <u>275'</u> (material) (depth)			
<u>2"</u> If telescope see back. (size)			
(5) screen <u>10'</u> , <u>275'</u> (length) (depth to top)			
<u>2"</u> , <u>P.V.C.</u> (size) (material)			
(6) pump _____ (HP) (yield gpm)			
(type power)			
(7) electric log <u>NO</u> (yes or no)			
(organization running log)			
(8) how well bottom plugged <u>Backwash valve</u>			
DRILLERS REMARKS:			

If well telescopes please sketch and show depths.

GROUND LEVEL

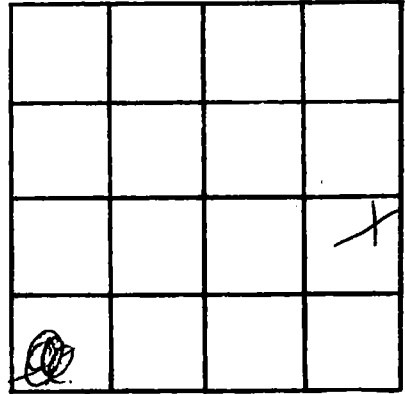

SECTION 2

Please indicate well location X.

ADDITIONAL INFORMATION

If more than one screen, show locations of each on sketch.