

**JACKSON**  
 P 366  
 11-1-73

MISSISSIPPI  
 BOARD OF WATER COMMISSIONERS  
 416 North State Street  
 Jackson, Mississippi 39201

CODED

WATER WELL DRILLERS LOG

COAST WATER WELL SERVICE

Jackson

11/1  
 date well completed

19 73

firm name

county well located

LANDOWNER: J. A. Judd  
TUCEI  
Rt. 2

description of formations encountered

from

to

Hautier, Mo. 39553  
 (mailing address)

top soil

0

5

WELL LOCATION:

sec. 8 T. 48 N. R. 6 W.  
in Hautier, Mo.  
 (distance) miles (direction) of (nearest town)

Blue Clay

5

20

fine sand

20

82

Coarse sand

82

123

WELL PURPOSE:

(home, irrigation, municipal, industrial)

Blue Clay

123

150

WELL COMPLETION DATA:

- (1) diameter (inches) 2"
- (2) total depth (feet) 398'
- (3) static water level (feet) 50' <sup>(below)</sup> top of ground <sub>above</sub>
- (4) casing P.V.C., 398'  
 (material) (depth)  
2" if telescope see back.  
 (size)
- (5) screen 10', 398'  
 (length) (depth to top)  
2", P.V.C.  
 (size) (material)
- (6) pump \_\_\_\_\_  
 (HP) (yield gpm)  
 \_\_\_\_\_  
 (type power)
- (7) electric log NO  
 (yes or no)  
 \_\_\_\_\_  
 (organization running log)
- (8) how well bottom plugged  
lock wash valve

fine sand

150

164

Blue Clay

164

184

fine sand

184

286

Coarse sand

286

307

Blue Clay

307

328

Coarse sand

328

349

Blue Clay

349

387

Coarse sand

387

398


DRILLERS REMARKS:

MISS. BD. OF WATER COMMISSIONERS

MISS. BD. OF WATER COMMISSIONERS

If well telescopes please sketch and show depths.

GROUND LEVEL

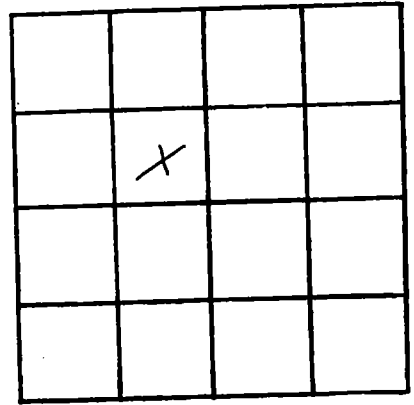

SECTION 31

Please indicate well location X.

ADDITIONAL INFORMATION

If more than one screen,  
show locations of each on sketch.