

JACKSON
P368
2-5-74

MISSISSIPPI
 BOARD OF WATER COMMISSIONERS
 416 North State Street
 Jackson, Mississippi 39201

CODED

WATER WELL DRILLERS LOG

date well completed 2/5 19 74 firm name Jackson county well located Jackson

LANDOWNER: Small Wade
903 Market St.
Pascagoula, Missi
 (mailing address)

description of formations encountered	from	to
	<u>top soil</u>	<u>0</u>
<u>clay</u>	<u>21</u>	<u>42</u>

WELL LOCATION:
 sec. 26 T. 7 S. R. 6 W.
 miles in of Hattiesburg
 (distance) (direction) (nearest town)

<u>clay + coarse sand</u>	<u>42</u>	<u>63</u>
<u>coarse sand</u>	<u>63</u>	<u>84</u>

WELL PURPOSE: Home
 (home, irrigation, municipal, industrial)

CODED

WELL COMPLETION DATA:

(1) diameter (inches) 2"

(2) total depth (feet) 85'

(3) static water level (feet) 20 below top of ground.

(4) casing PVC, 80'
 (material) (depth)

2" if telescope see back.
 (size)

(5) screen 5', 80'
 (length) (depth to top)

2", PVC
 (size) (material)

(6) pump 1/2, 8
 (HP) (yield gpm)

elec.
 (type power)

(7) electric log NO
 (yes or no)

(organization running log)

(8) how well bottom plugged B.V. Valve


DRILLERS REMARKS:

RECEIVED

JUL 12 1974

If well telescopes please sketch and show depths.

GROUND LEVEL

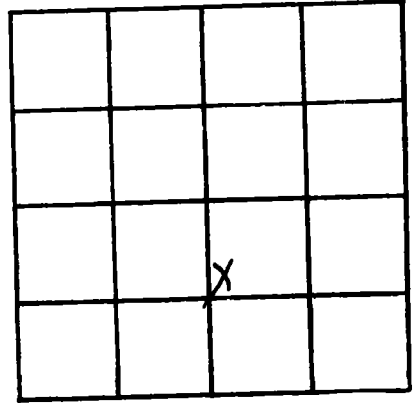

SECTION 26

Please indicate well location X.

ADDITIONAL INFORMATION

If more than one screen,
show locations of each on sketch.