

JACKSON
P 369
5-27-74

MISSISSIPPI
BOARD OF WATER COMMISSIONERS
416 North State Street
Jackson, Mississippi 39201

CODED


WATER WELL DRILLERS LOG

May 27 1974 *Colville Water Supply* Jackson
(date well completed) (firm name) (county well located)

LANDOWNER: <i>Otis Barnes</i>	description of formations encountered	from	to
<i>Eastway Ms.</i> (mailing address)	Clay 0-22 sand 22-30 sand 30-370		
WELL LOCATION: sec. <u>11</u> T. <u>7</u> N. R. <u>6</u> E. <u>4</u> miles <u>West</u> of <u>MP.</u> (distance) (direction) (nearest town)	Clay 0-22 sand 22-30 Clay 30-370 sand 370-392	0	22 30 370 392
WELL PURPOSE: <i>Home</i> (home, irrigation, municipal, industrial)	CODED		
WELL COMPLETION DATA:			
(1) diameter (inches) <u>2</u>			
(2) total depth (feet) <u>392</u>			
(3) static water level (feet) <u>48' 10"</u> ^{below} / _{above} top of ground			
(4) casing <u>plastic</u> , <u>10</u> (material) (depth)			
<u>2</u> If telescope see back. (size)			
(5) screen <u>10</u> , <u>382</u> (length) (depth to top)			
<u>2</u> , <u>stainless</u> (size) (material)			
(6) pump <u>1 1/2</u> , <u>10</u> (HP) (yield gpm)			
<u>elec</u> (type power)			
(7) electric log <u>no</u> (yes or no)			
(organization running log)			
(8) how well bottom plugged <u>BP Valve</u>	RECORDED		
DRILLERS REMARKS:	SEP 26 1974		

If well telescopes please sketch and show depths.

GROUND LEVEL

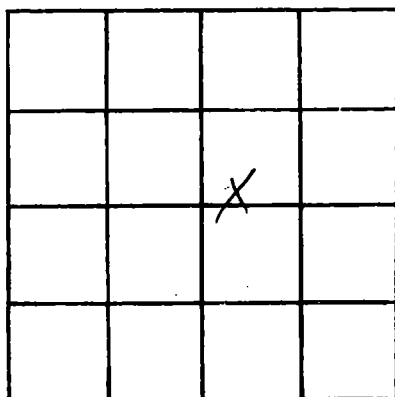

SECTION 11

Please indicate well location X.

ADDITIONAL INFORMATION

If more than one screen, show locations of each on sketch.