

**MISSISSIPPI  
BOARD OF WATER COMMISSIONERS**  
416 North State Street  
Jackson, Mississippi 39201

**WATER WELL DRILLERS LOG**

Jackson  
P 371  
11-30-74

11/30 1974 COAST WATER WELL SERVICE Jackson  
date well completed firm name county well located

**LANDOWNER:** Paul Roberts + James Mc Donald  
P.O. Box 266  
Pascagoula, Mo.  
(mailing address)

description of formations encountered	from	to
<u>top soil</u>	<u>0</u>	<u>5</u>
<u>blue clay</u>	<u>5</u>	<u>23</u>
<u>fine sand</u>	<u>23</u>	<u>30</u>
<u>blue clay</u>	<u>30</u>	<u>80</u>
<u>coarse sand + gravel</u>	<u>80</u>	<u>138</u>
<u>blue clay</u>	<u>138</u>	<u>148</u>
<u>coarse sand</u>	<u>148</u>	<u>157</u>
<u>blue clay</u>	<u>157</u>	<u>220</u>
<u>fine + med. sand</u>	<u>220</u>	<u>240</u>
<u>coarse sand</u>	<u>240</u>	<u>301</u>

**WELL LOCATION:**  
sec. 9 T. 8 R. 6  
miles In Gautier of (nearest town)

**WELL PURPOSE:** Home  
(home, irrigation, municipal, industrial)

**WELL COMPLETION DATA:**

(1) diameter (inches) 2"

(2) total depth (feet) 301

(3) static water level (feet) 18 below top of ground.

(4) casing PVC, 291' (material) (depth)

2" (size) if telescope see back.

(5) screen 10', 291' (length) (depth to top)

2", PVC (size) (material)

(6) pump 1, 8 1/2 (HP) (yield gpm)


elec. (type power)

(7) electric log NO (yes or no)

(organization running log)

(8) how well bottom plugged BWW


**DRILLERS REMARKS:**

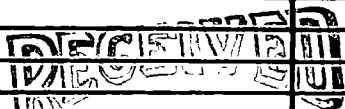

MISS. BD. OF WATER COMMISSIONERS

If well telescopes please sketch and show depths.

GROUND LEVEL

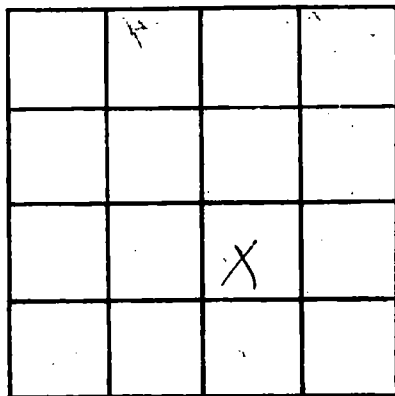

SECTION 9

Please indicate well location X.

ADDITIONAL INFORMATION

If more than one screen, show locations of each on sketch.