

MISSISSIPPI  
BOARD OF WATER COMMISSIONERS **CODED**  
416 North State Street  
Jackson, Mississippi 39201

WATER WELL DRILLERS LOG

JACKSON  
P373

9/76

E Log # 224

SEPT 1976

19 Holland Wells Inc

Jackson

date well completed

firm name

county well located

LANDOWNER:

Ingalls Shipbuilding

Pascagoula, MS.  
(mailing address)

description of formations encountered

from

to

SAND

0 20

SOFT CLAY

20 60

SAND GRAVEL

60 100

CLAY

100 120

SAND

120 137

CLAY

137 232

SAND

230 320

**CODED**


**RECEIVED**

MAY 12 1978

MISS. BD. OF WATER COMME

WELL LOCATION:

NOT ON MAP

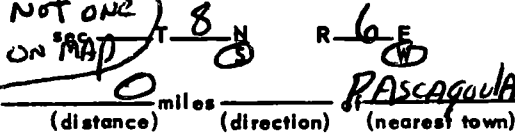

WELL PURPOSE:

INDUSTRIAL  
(home, irrigation, municipal, industrial)

WELL COMPLETION DATA:

(1) diameter (inches) 14

(2) total depth (feet) 320

(3) static water level (feet) 42 below top of ground.

(4) casing Black Steel  
(material) (depth)

(size) If telescope see back.

(5) screen 80 240  
(length) (depth to top)

10" SSS  
(size) (material)

(6) pump 75  
(HP) (yield gpm)

Elek  
(type power)

(7) electric log Yes  
(yes or no)

MGS  
(organization running log)

(8) how well bottom plugged Backwash Valve

DRILLERS REMARKS:

