

JACKSON
P 385
12/11/78

MISSISSIPPI
BOARD OF WATER COMMISSIONERS
416 North State Street
Jackson, Mississippi 39201

CODED

WATER WELL DRILLERS LOG

12-11-78 date well completed
Coast Water Well Service firm name
Jackson county well located

LANDOWNER	description of formations encountered	from	to
<p>Gulf City Trucking P.O. Box 1346 Cedar Pascagoula miss. (mailing address) 39267</p>	Top soil	0	10
<p>WELL LOCATION: sec. 7 T. 8 R. 6 in miles City Pascagoula (distance) (direction) (nearest town)</p>	Gray Clay	10	23
<p>WELL PURPOSE: Industrial (home, irrigation, municipal, industrial)</p>	Blue Clay	23	45
<p>WELL COMPLETION DATA: (1) diameter (inches) 8" x 6" (2) total depth (feet) 327' (3) static water level (feet) 64' below top of ground. (4) casing Steel, 267' (material) (depth) 8" x 6" (size) if telescope see back. (5) screen 60' (length) 267' (depth to top) 8" x 6" (size) Steel (material) (6) pump 2.5 (HP) 350 (yield gpm) Elect. (type power) (7) electric log No. (yes or no) (organization running log)</p>	White Coarse sand	45	56
	Log decayed wood	56	57
	White Coarse sand	57	60
	Log - decayed wood	60	61
	White Coarse sand	61	89
	Blue Clay	89	110
	Gray Coarse sand + gravel	110	176
	Blue Clay	170	220
	Gray med. sand	220	230
	judged	230	327

(8) How well bottom plugged
6" back wash valve

Miss. Board of Water


MAY 29 1979

DRILLERS REMARKS:

RECEIVED

If well telescopes please sketch and show depths.

GROUND LEVEL

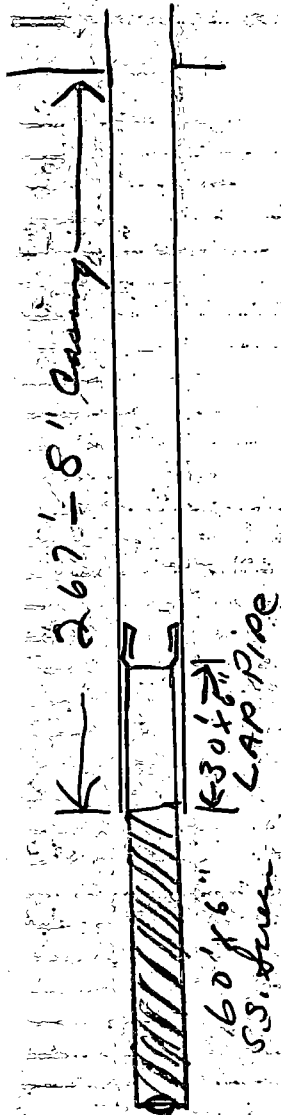

	X		

SECTION 1

Please indicate well location X.

ADDITIONAL INFORMATION

If more than one screen, show locations of each on sketch.