

MISSISSIPPI DEPARTMENT OF NATURAL RESOURCES

Bureau of Land and Water Resources

Southport Mall

P.O. Box 10631

CODED

Jackson, Mississippi 39209

WATER WELL DRILLERS LOG

JACKSON  
P 386  
2-23-81  
2-23-81

date well completed 19 2-23-81 firm name Cross Water Well Serv. Inc. Jackson county well located \_\_\_\_\_

LANDOWNER: C. R. Cooke  
1508 Skyline Dr.  
La Motte Estates  
Dawson, Miss. 39553  
(mailing address)

description of formations encountered	from	to
<u>Sandy Top soil</u>	<u>0</u>	<u>15'</u>
<u>Blue Clay</u>	<u>15'</u>	<u>75'</u>
<u>Cl sand</u>	<u>75'</u>	<u>105'</u>

WELL LOCATION:  
sec. 4 T-8 S R-6 W  
1/4 miles (distance) of GAULTIER (direction) of (nearest town)

WELL PURPOSE: Home  
(home, irrigation, municipal, industrial)

WELL COMPLETION DATA:

- (1) diameter (inches) 2"
- (2) total depth (feet) 105'
- (3) static water level (feet) 18' below top of ground.
- (4) casing PVC, 95'  
(material) (depth)
- (5) screen 2" if telescope see back.  
(size) 10' 95'  
(length) (depth to top)
- (6) pump 1 1/2 hp, 6  
(HP) (yield gpm)
- Elior  
(type power)
- (7) electric log No.  
(yes or no)

(organization running log)

(8) how well bottom plugged: back wash water

DEPT. OF NATURAL RESOURCES  
BUREAU OF LAND & WATER RESOURCES


APR -7 1981

DRILLERS REMARKS:

RECEIVED

If well telescopes please sketch and show depths.

GROUND LEVEL

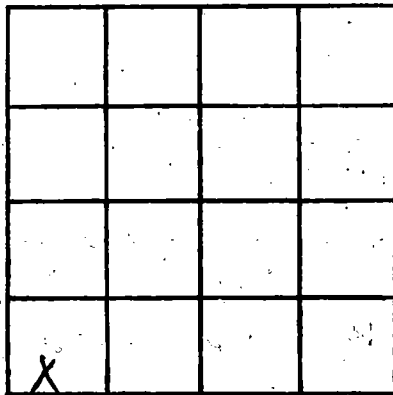

SECTION

4FG

Please indicate well location X.

ADDITIONAL INFORMATION

If more than one screen, show locations of each on sketch.