

MISSISSIPPI DEPARTMENT OF NATURAL RESOURCES

Bureau of Land and Water Resources

Southport Mall

P.O. Box 10631

Jackson, Mississippi 39205

CODED

WATER WELL DRILLERS LOG

JACKSON
P 390
6-18-81

6-18-81 date well completed 81 Coast Water Well Sew. firm name Jackson county well located

LANDOWNER:	description of formations encountered	from	to
Hudson Shipyard	Top soil	0	2'
P.O. Box 0	White coarse sand		
Pascagoula, Miss. (mailing address) 39567	and wood	2'	68'
WELL LOCATION: NO SECTION ON MAP	White coarse sand		
sec. 7 T 8 N R 6 E	wood & gravel	68'	189'
1 N miles of PASCAGOULA (distance) (direction) (nearest town)	Blue clay	189'	214'
WELL PURPOSE: Industrial (home, irrigation, municipal, industrial)	Gray coarse sand	214'	300'
WELL COMPLETION DATA:			
(1) diameter (inches) 6"			
(2) total depth (feet) 300'			
(3) static water level (feet) 27' below top of ground			
(4) casing PVC, 380' (material) (depth)			
6" (size) if telescope see back.			
(5) screen 20' length, 380' depth to top			
6" (size), PVC (material)			
(6) pump 15 hp, 160 (HP) (yield gpm)			
Elect. (type power)			
(7) electric log No. (yes or no)			
(organization running log)			
(8) how well bottom plugged			
Back Wash Valve			




DRILLERS REMARKS:

If well telescopes please sketch and show depths.

7-1000

GROUND LEVEL

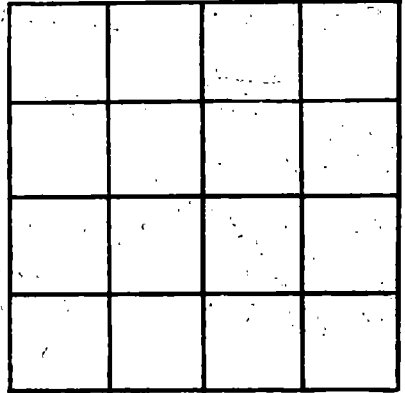

SECTION _____

Please indicate well location X.

ADDITIONAL INFORMATION

APPROX. 1000 FT. SOUTH OF
U.S. HWY. 90 AND
1000 - FT WEST OF THE
PASCAGOULLA RIVER.
NO SECTION WAS AN ~~ADDER~~

If more than one screen,
show locations of each on sketch.