

Jackson  
P 391  
10-20-81

MISSISSIPPI DEPARTMENT OF NATURAL RESOURCES  
Bureau of Land and Water Resources  
Southport Mall  
P.O. Box 10631  
Jackson, Mississippi 39209  
**CODED**  
WATER WELL DRILLERS LOG

10-20-81 date well completed  
81 Coast Water Well Serv. Inc. firm name  
Jackson county well located

LANDOWNER: Toku Restaurant  
P.O. Drawer 8,  
Gautier, Miss. 39553  
(mailing address)

Description of formations encountered	from	to
Top soil	0	10'
B. Clay-Md. Sand	10'	65'
C. sand G.	65'	100'
B. Clay	100'	220'
M. sand	220'	280'

WELL LOCATION:  
sec. 8 T. 15 S. R. 6 W.  
1N miles (distance) of GAUTIER (nearest town)  
(direction)

WELL PURPOSE:  
(home, irrigation, municipal, industrial)

- WELL COMPLETION DATA:
- (1) diameter (inches) 4"
  - (2) total depth (feet) 280'
  - (3) static water level (feet) -30' below top of ground.
  - (4) casing PVC 270'  
(material) (depth)  
4" If telescope see back.  
(size)
  - (5) screen 10' 270'  
(length) (depth to top)  
4" PVC  
(size) (material)
  - (6) pump 2 hp. 50  
(HP) (yield gpm)  
elec.  
(type power)
  - (7) electric log No.  
(yes or no)  
  
(organization running log)
  - (8) how well bottom plugged  
Backwash valve

**CODED**

DEPT. OF NATURAL RESOURCES  
BUREAU OF LAND & WATER RESOURCES


NOV 18 1981

**RECEIVED**

DRILLERS REMARKS:

If well telescopes please sketch and show depths.

GROUND LEVEL

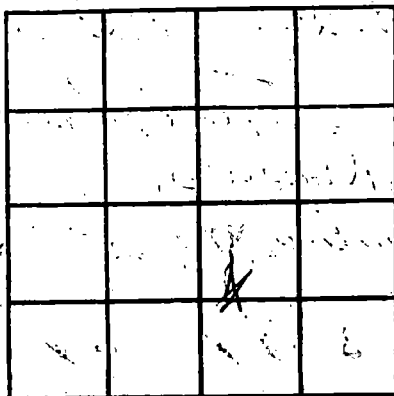

SECTION FC8

Please indicate well location X.

**ADDITIONAL INFORMATION**

If more than one screen, show locations of each on sketch.