

MISSISSIPPI DEPARTMENT OF NATURAL RESOURCES

Bureau of Land and Water Resources

Southport Mall

P.O. Box 10631

Jackson, Mississippi 39209

WATER WELL DRILLERS LOG

CODED

Jackson
P393
5-21-82

5-21-82 date well completed
Coast Water Well Sew. firm name
Jackson county well located

LANDOWNER: LaFont's Inn
P.O. Box 1028
Pascagoula, Miss.
(mailing address) 39567

description of formations encountered	from	to
Top soil	0	2'
Clay	2'	62'
C. sand	62'	100'

WELL LOCATION:
sec. 1 T. 8 N. R. 6 E
1 miles (distance) N (direction) of PASCAGOULA (nearest town)

WELL PURPOSE: Drainage
(home, irrigation, municipal, industrial)

CODED

WELL COMPLETION DATA:

(1) diameter (inches) 4"

(2) total depth (feet) 100'

(3) static water level (feet) 20' below top of ground.

(4) casing PVC (material), 90' (depth)
4" (size) if telescope see back.

(5) screen 10' (length), 90' (depth to top)
4" (size), PVC (material)

(6) pump 2hp (HP), 45 (yield gpm)
Elect. (type power)

(7) electric log No (yes or no)

(organization running log)

(8) how well bottom plugged: Backwash Valve

DRILLERS REMARKS:


DEPT. OF NATURAL RESOURCES
BUREAU OF LAND & WATER RESOURCES

JUN - 4 1982

RECEIVED

If well telescopes please sketch and show depths.

GROUND LEVEL

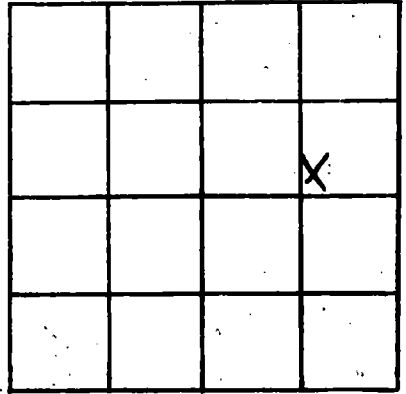

SECTION 1

Please indicate well location X.

ADDITIONAL INFORMATION

If more than one screen, show locations of each on sketch.