

JACKSON
P 396
10-15-82

MISSISSIPPI DEPARTMENT OF NATURAL RESOURCES
Bureau of Land and Water Resources
Southport Mall
P.O. Box 10631
Jackson, Mississippi 39209
WATER WELL DRILLERS LOG

CODED

10-15 1982 date well completed
BRADEN Pump & Well SERVICE, INC. firm name
Jackson county well located

LANDOWNER:
Gulf City Fisheries
P.O. Box 1346
4111 Cedar St.
Pascagoula, MS (mailing address)

WELL LOCATION:
sec. 7 T. 8 R. 6
On East Bank Pascagoula R.
(distance) miles (direction) of (nearest town)

WELL PURPOSE: Industrial
(home, irrigation, municipal, industrial)

WELL COMPLETION DATA:

- (1) diameter (inches) 8" x 6"
- (2) total depth (feet) 320
- (3) static water level (feet) 65 Below top of ground
- (4) casing Steel, 260 (material) (depth)
If telescope see back.
- (5) screen 60, 260 FT (length) (depth to top)
6" S.S. Under bor (size) (material)
- (6) pump 30 475 @ 35 # (HP) Turbine (yield gpm)
Line. Shaft 480V 30 (type power)
- (7) electric log No (yes or no)
(organization running log)
- (8) how well bottom plugged
6" Backwash Check

description of formations encountered	from	to
FILL & SAND	0	20
SAND & CLAY	20	40
SAND & CLAY	40	60
CLAY & SAND	60	80
SAND & CLAY	80	100
SAND & CLAY	100	120
SAND	120	140
SAND	140	160
SAND & CLAY	160	180
SAND & CLAY	180	200
SAND & CLAY	200	210
SAND	210	220
SAND	220	230
SAND & CLAY	230	240
SAND & CLAY	240	255
SAND	255	260
SAND	260	270
SAND	270	280
SAND	280	290
SAND	290	300
SAND	300	310
SAND	310	320

CODED

DEPT. OF NATURAL RESOURCES
BUREAU OF LAND & WATER RESOURCES

OCT 25 1982

RECEIVED

DRILLERS REMARKS:

If well telescopes please sketch and show depths.

GROUND LEVEL

FW
Steel
Cemented


6" steel
260

240 FT
6" x 1/2"
Lead Seal

60 FT
6" S.S.
Underbar
Screen

320

6" B.W.
Check

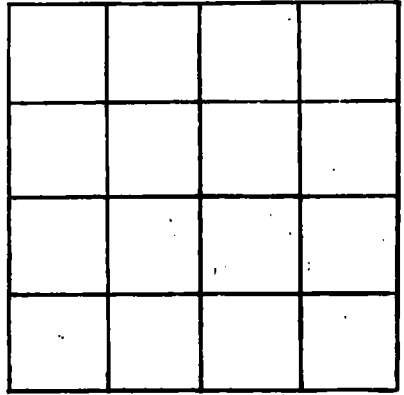

SECTION 7

Please indicate well location X.

ADDITIONAL INFORMATION

If more than one screen,
show locations of each on sketch.