

MISSISSIPPI DEPARTMENT OF NATURAL RESOURCES
 Bureau of Land and Water Resources
 Southport Mall
 P.O. Box 10631
 Jackson, Mississippi 39209
 WATER WELL DRILLERS LOG

JACKSON
 P400

CODED

8-7-1984 Price Drilling Co Jackson
 date well completed firm name county well located

LANDOWNER: Frank Hamilton
Creole Bayou
Pascagoula, ms
 (mailing address)

description of formations encountered	from	to
<u>Topsoil</u>	<u>0</u>	<u>20</u>
<u>Sand</u>	<u>20</u>	<u>80</u>
<u>Clay</u>	<u>80</u>	<u>100</u>
<u>Sand</u>	<u>100</u>	<u>180</u>
<u>Clay</u>	<u>180</u>	<u>200</u>
<u>good Sand</u>	<u>200</u>	<u>260</u>

WELL LOCATION:
 sec. 4 T 7 N R. 6 E
4 miles West of Pascataupa
 (distance) (direction) (nearest town)

WELL PURPOSE: Camp #3
 (home, irrigation, municipal, industrial)

- WELL COMPLETION DATA:
- diameter (inches) 2"
 - total depth (feet) 260'
 - static water level (feet) 30' ^{below} above top of ground
 - casing Plastic, 250'
 (material) (depth)
0 If telescope see back.
 (size)
 - screen 10', 260'
 (length) (depth to top)
008, plastic
 (size) (material)
 - pump 1 10
 (HP) (yield gpm)
electric
 (type power)
 - electric log (yes or no)
 (organization running log)
 - how well bottom plugged BW

CODED

DEPT. OF NATURAL RESOURCES
 BUREAU OF LAND & WATER RESOURCES


OCT 31 1984

RECEIVED

DRILLERS REMARKS:

If well telescopes please sketch and show depths.

GROUND LEVEL

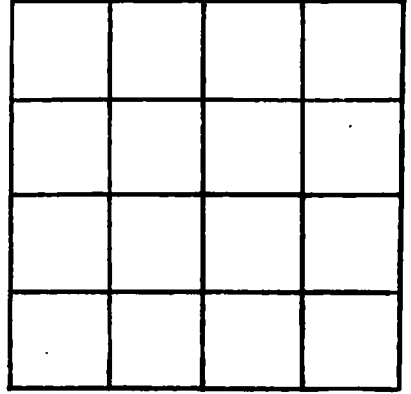

SECTION _____

Please indicate well location X.

ADDITIONAL INFORMATION

If more than one screen,
show locations of each on sketch.