

MISSISSIPPI DEPARTMENT OF NATURAL RESOURCES

Bureau of Land and Water Resources

Southport Mall

P.O. Box 10631

Jackson, Mississippi 39209

CODED

WATER WELL DRILLERS LOG

JACKSON
P402

8-14 1984 *Luce Drilling Co* Jackson
 date well completed firm name county well located

LANDOWNER: *Frank Hamilton*
Creole Bayou
Pascagoula ms
 (mailing address)

description of formations encountered	from	to
<i>top soil</i>	<i>0</i>	<i>20</i>
<i>Sand</i>	<i>20</i>	<i>80</i>
<i>Clay</i>	<i>80</i>	<i>100</i>
<i>Sand</i>	<i>100</i>	<i>180</i>
<i>clay</i>	<i>180</i>	<i>200</i>
<i>good sand</i>	<i>200</i>	<i>260</i>

WELL LOCATION:
 sec. *4* T. *7* N. R. *6* E
4 miles *West* of *Escatawpa*
 (distance) (direction) (nearest town)

WELL PURPOSE: *Camp #5*
 (home, irrigation, municipal, industrial)

CODED

WELL COMPLETION DATA:

(1) diameter (inches) *2"*

(2) total depth (feet) *260'*

(3) static water level (feet) *30'* ^{below} _{above} top of ground.

(4) casing *plastic, 250'*
 (material) (depth)
0 if telescope see back.
 (size)

(5) screen *10'*, *260'*
 (length) (depth to top)
008, *plastic*
 (size) (material)

(6) pump *1* *10*
 (HP) (yield gpm)
electric
 (type power)

(7) electric log *(yes or no)*
 (organization running log)

(8) how well bottom plugged *BW*

DEPT. OF NATURAL RESOURCES
 BUREAU OF LAND & WATER RESOURCES


OCT 31 1984

RECEIVED

DRILLERS REMARKS:

If well telescopes please sketch and show depths.

GROUND LEVEL

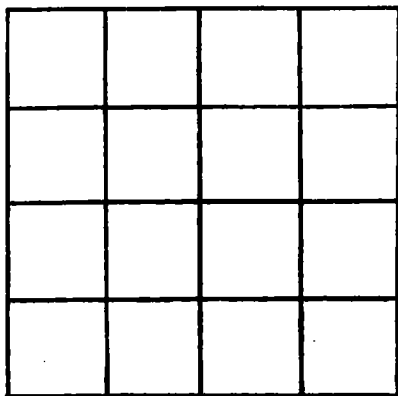

SECTION _____

Please indicate well location X.

ADDITIONAL INFORMATION

If more than one screen, show locations of each on sketch.