

MISSISSIPPI DEPARTMENT OF NATURAL RESOURCES

Bureau of Land and Water Resources

Southport Mall

P.O. Box 10631

Jackson, Mississippi 39209

CODED

WATER WELL DRILLERS LOG

JACKSON
P403

8-17 1984 Pierce Drilling Co Jackson
date well completed firm name county well located

LANDOWNER: Frank Hamilton
Creole Bayou
Pascagoula Ms
(mailing address)

description of formations encountered	from	to
<u>top soil</u>	<u>0</u>	<u>20</u>
<u>sand</u>	<u>20</u>	<u>80</u>
<u>Clay</u>	<u>80</u>	<u>100</u>
<u>sand</u>	<u>100</u>	<u>180</u>
<u>Clay</u>	<u>180</u>	<u>200</u>
<u>Good Sand</u>	<u>200</u>	<u>260</u>

WELL LOCATION:
sec. 4 T. 7 N. R. 6 E.
4 miles west of Easthrop
(distance) (direction) (nearest town)

CODED

WELL PURPOSE: Camp # 6
(home, irrigation, municipal, industrial)

WELL COMPLETION DATA:

- (1) diameter (inches) 2"
- (2) total depth (feet) 260'
- (3) static water level (feet) 30' below above top of ground.
- (4) casing plastic, 250'
(material) (depth)
0 if telescope see back.
(size)
- (5) screen 10', 260'
(length) (depth to top)
008, plastic
(size) (material)
- (6) pump 1 10
(HP) (yield gpm)
electric
(type power)
- (7) electric log (yes or no)
(organization running log)
- (8) how well bottom plugged BW

DEPT. OF NATURAL RESOURCES
BUREAU OF LAND & WATER RESOURCES


OCT 31 1984

RECEIVED

DRILLERS REMARKS:

If well telescopes please sketch and show depths.

GROUND LEVEL

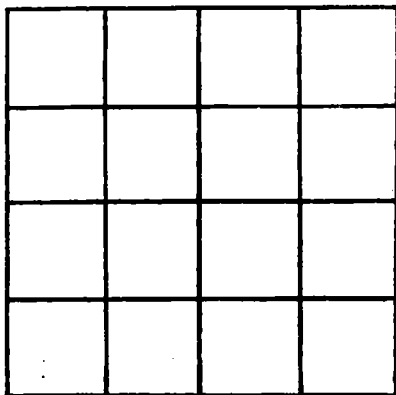

SECTION _____

Please indicate well location X.

ADDITIONAL INFORMATION

If more than one screen, show locations of each on sketch.