

MISSISSIPPI DEPARTMENT OF NATURAL RESOURCES

Bureau of Land and Water Resources

Southport Mall

P.O. Box 10631

CODED

Jackson, Mississippi 39209

WATER WELL DRILLERS LOG

JACKSON
P404

8-21-1984 date well completed
Pucci Drilling Co. firm name
Jackson county well located

LANDOWNER: Frank Hamilton
Creole Bayou
Pascagoula, Ms
(mailing address)

description of formations encountered	from	to
Top soil	0	20
Sand	20	30
Clay	30	100
Sand	100	180
Clay	180	200
good Sand	200	260

WELL LOCATION:
sec. 4 T 7 N R 6 E
4 miles West of Eastlawpa
(distance) (direction) (nearest town)

WELL PURPOSE: Camp #7
(home, irrigation, municipal, industrial)

- WELL COMPLETION DATA:
- (1) diameter (inches) 2"
 - (2) total depth (feet) 260'
 - (3) static water level (feet) 30' below top of ground.
 - (4) casing plastic, 250' (material) (depth)
0 (size) if telescope see back.
 - (5) screen 10' , 260' (length) (depth to top)
008 , plastic (size) (material)
 - (6) pump 1 (HP) 10 (yield gpm)
electric (type power)
 - (7) electric log (yes or no)

(organization running log)
(8) how well bottom plugged BW

DRILLERS REMARKS:

CODED


DEPT. OF NATURAL RESOURCES
BUREAU OF LAND & WATER RESOURCES

OCT 31 1984

RECEIVED

If well telescopes please sketch and show depths.

GROUND LEVEL

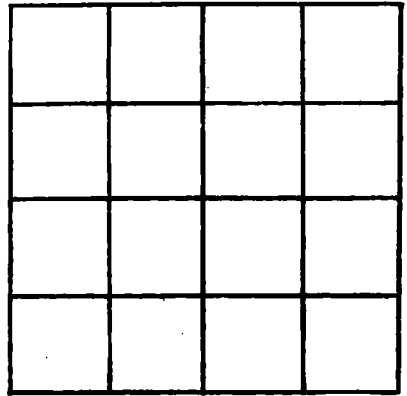

SECTION _____

Please indicate well location X.

ADDITIONAL INFORMATION

If more than one screen, show locations of each on sketch.