

MISSISSIPPI DEPARTMENT OF NATURAL RESOURCES

Bureau of Land and Water Resources

Southport Mall

P.O. Box 10631

CODED.

Jackson, Mississippi 39209

WATER WELL DRILLERS LOG

JACKSON

P405

8-24 1984

Pierce Drilling Co.

Jackson

date well completed

firm name

county well located

LANDOWNER: Frank Hamito

description of formations encountered

from

to

Creole Bayou

Top soil

0 20

Pascagoula, ms
(mailing address)

Sand

20 80

Clay

80 100

Sand

100 180

Clay

180 200

good sand

200 260

WELL LOCATION:

sec. 4 T 7 N R 6 E
4 miles west of Escatawpa
(distance) (direction) (nearest town)

WELL PURPOSE: Camp # 8
(home, irrigation, municipal, industrial)

CODED.

WELL COMPLETION DATA:

- (1) diameter (inches) 2"
- (2) total depth (feet) 260'
- (3) static water level (feet) 30' below top of ground
- (4) casing plastic 250' (material) (depth)
- (size) 0 If telescope see back.
- (5) screen 10' 260' (length) (depth to top)
- (size) 008, plastic (material)
- (6) pump 1 10 (HP) (yield gpm)
- (type power) electric
- (7) electric log (yes or no)

(organization running log)

(8) how well bottom plugged BW


DEPT. OF NATURAL RESOURCES
BUREAU OF LAND & WATER RESOURCES

OCT 31 1984
RECEIVED

DRILLERS REMARKS:

If well telescopes please sketch and show depths.

GROUND LEVEL

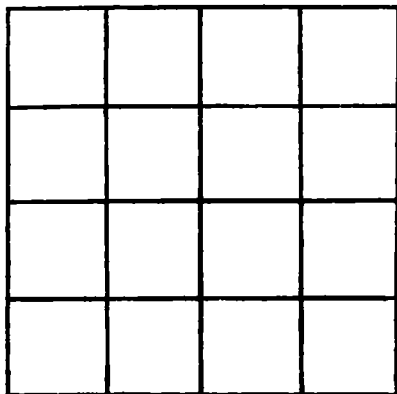

SECTION _____

Please Indicate well location X.

ADDITIONAL INFORMATION

If more than one screen, show locations of each on sketch.