

MISSISSIPPI DEPARTMENT OF NATURAL RESOURCES

Bureau of Land and Water Resources

Southport Mall

P.O. Box 10631

CODED

Jackson, Mississippi 39209

WATER WELL DRILLERS LOG

JACKSON
P406

829 1984 date well completed *Luce Drilling Co.* firm name *Jackson* county well located

LANDOWNER: *Frank Hamilton*

Crode Bayou
Pascagoula, Ms
(mailing address)

WELL LOCATION:

sec. 4 T 7 N R 6 E
4 miles west of Ecatawpa
(distance) (direction) (nearest town)

WELL PURPOSE: Camp #9
(home, irrigation, municipal, industrial)

WELL COMPLETION DATA:

- (1) diameter (inches) 2"
- (2) total depth (feet) 260'
- (3) static water level (feet) 30' ^{below} _{above} top of ground.
- (4) casing plastic, 250'
(material) (depth)
9 if telescope see back.
(size)
- (5) screen 10', 260'
(length) (depth to top)
008, plastic
(size) (material)
- (6) pump 1 10
(HP) (yield gpm)
electric
(type power)
- (7) electric log (yes or no)

(organization running log)

(8) how well bottom plugged BW

DRILLERS REMARKS:

description of formations encountered	from	to
<i>Topsoil</i>	<i>0</i>	<i>20</i>
<i>sand</i>	<i>20</i>	<i>80</i>
<i>Clay</i>	<i>80</i>	<i>100</i>
<i>Sand</i>	<i>100</i>	<i>180</i>
<i>Clay</i>	<i>180</i>	<i>200</i>
<i>Good Sand</i>	<i>200</i>	<i>260</i>

CODED


DEPT. OF NATURAL RESOURCES
BUREAU OF LAND & WATER RESOURCES

OCT 31 1984

RECEIVED

If well telescopes please
sketch and show depths.

GROUND LEVEL

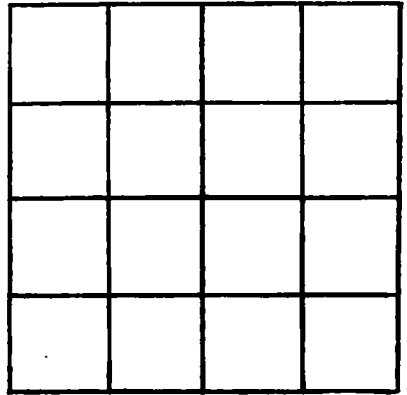

SECTION _____

Please indicate well location X.

ADDITIONAL INFORMATION

If more than one screen,
show locations of each on sketch.