

MISSISSIPPI DEPARTMENT OF NATURAL RESOURCES

Bureau of Land and Water Resources

Southport Mall

P.O. Box 10631

CODED

Jackson, Mississippi 39209

WATER WELL DRILLERS LOG

JACKSON  
P407

9-1 1984 Pierce Drilling Co. Jackson  
date well completed firm name county well located

LANDOWNER: Frank Hamilton

description of formations encountered

from

to

Cyote Bayou  
Passapatanz Ms  
(mailing address)

Top soil	0	20
Sand	20	80
Clay	80	100
Sand	100	180
Clay	180	200
good Sand	200	260

WELL LOCATION:

sec. 4 T 7 N R 6 E  
4 miles west of Passapatanz  
(distance) (direction) (nearest town)

WELL PURPOSE: Camp #10  
(home, irrigation, municipal, industrial)

CODED

WELL COMPLETION DATA:

- (1) diameter (inches) 2"
- (2) total depth (feet) 260'
- (3) static water level (feet) 30' below top of ground.
- (4) casing plastic, 250' (material) (depth)
- (5) screen 10' (length), 260' (depth to top)
- 008, plastic (size) (material)
- (6) pump 1 (HP), 10 (yield gpm)
- electric (type power)
- (7) electric log (yes or no)

(organization running log)

(8) how well bottom plugged BW


DRILLERS REMARKS:

DEPT. OF NATURAL RESOURCES  
BUREAU OF LAND & WATER RESOURCES

OCT 31 1984  
RECEIVED

If well telescopes please sketch and show depths.

GROUND LEVEL

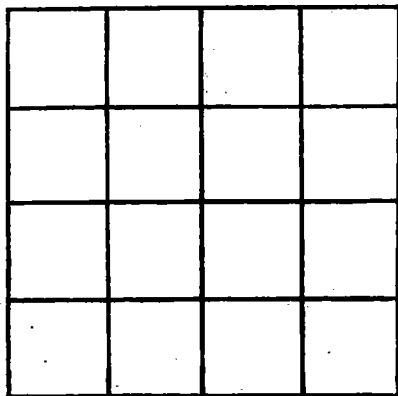

SECTION \_\_\_\_\_

Please indicate well location X.

ADDITIONAL INFORMATION

If more than one screen, show locations of each on sketch.