

JACKSON  
P408

MISSISSIPPI DEPARTMENT OF NATURAL RESOURCES  
Bureau of Land and Water Resources  
Southport Mall  
P.O. Box 10631  
Jackson, Mississippi 39209 CODED  
WATER WELL DRILLERS LOG

9-5 1984 Price Drilling Co. Jackson  
date well completed firm name county well located

LANDOWNER: Frank Hamish  
Creole Bayou  
Pascagoula, ms  
(mailing address)

WELL LOCATION:  
sec. 4 T. 7 N. R. 6 E  
4 miles West of Escatawpa  
(distance) (direction) (nearest town)

WELL PURPOSE: camp # 11  
(home, irrigation, municipal, industrial)

- WELL COMPLETION DATA:
- (1) diameter (inches) 2"
  - (2) total depth (feet) 260'
  - (3) static water level (feet) 30' <sup>below</sup> above top of ground.
  - (4) casing plastic, 250'  
(material) (depth)  
0 if telescope see back.  
(size)
  - (5) screen 10', 260'  
(length) (depth to top)  
208, plastic  
(size) (material)
  - (6) pump 1 10  
(HP) (yield gpm)  
electric  
(type power)
  - (7) electric log (yes or no)  
(organization running log)
  - (8) how well bottom plugged BW

description of formations encountered	from	to
<u>top soil</u>	<u>0</u>	<u>20</u>
<u>sand</u>	<u>20</u>	<u>80</u>
<u>clay</u>	<u>80</u>	<u>100</u>
<u>sand</u>	<u>100</u>	<u>180</u>
<u>clay</u>	<u>180</u>	<u>200</u>
<u>good sand</u>	<u>200</u>	<u>260</u>

CODED


DEPT. OF NATURAL RESOURCES  
BUREAU OF LAND & WATER RESOURCES

OCT 31 1984  
RECEIVED

DRILLERS REMARKS:

If well telescopes please  
sketch and show depths.

GROUND LEVEL

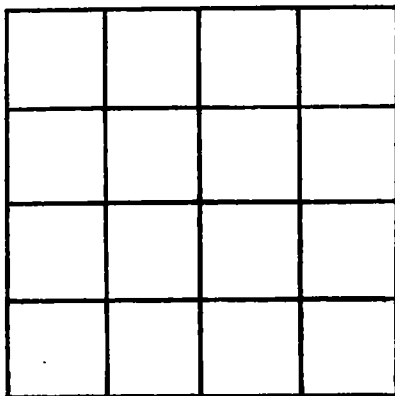

SECTION \_\_\_\_\_

Please indicate well location X.

ADDITIONAL INFORMATION

If more than one screen,  
show locations of each on sketch.