

MISSISSIPPI DEPARTMENT OF NATURAL RESOURCES
 Bureau of Land and Water Resources
 Southport Mall
 P.O. Box 10631
 Jackson, Mississippi 39209
WATER WELL DRILLERS LOG

CODED

4"
JACKSON
P 413

5-20-85 date well completed
 Coastal Water Well Sew. firm name
 Jackson county well located

LANDOWNER: James Talbrook
 1118 Driftwood
 Pascagoula, Miss.
 (mailing address) 39267

description of formations encountered	from	to
Top soil	0'	1'
White Med. Sand	1'	15'
Blue Clay	15'	45'
Blue Clay & Sand Shale	45'	38'
White Coarse sand	58'	90'

WELL LOCATION:
 sec. 6 T. 8 N R. 6 E
 S W
 PN miles of Pascagoula
 (distance) (direction) (nearest town)

WELL PURPOSE: ~~Municipal~~
 (home, irrigation, municipal, industrial)

WELL COMPLETION DATA:

(1) diameter (inches) 4"

(2) total depth (feet) 90'

(3) static water level (feet) 91' below top of ground.

(4) casing PVC 80' (material) (depth)
 4" (size) if telescope see back.

(5) screen 10' 80' (length) (depth to top)
 4" PVC (size) (material)

(6) pump 1/2 hp. 18 (HP) (yield gpm)
 Check. (type power)

(7) electric log No (yes or no)
 (organization running log)

(8) how well bottom plugged
 Back wash valve


CODED

RECEIVED
 JUL 10 1985

DRILLERS REMARKS:

If well telescopes please sketch and show depths.

GROUND LEVEL

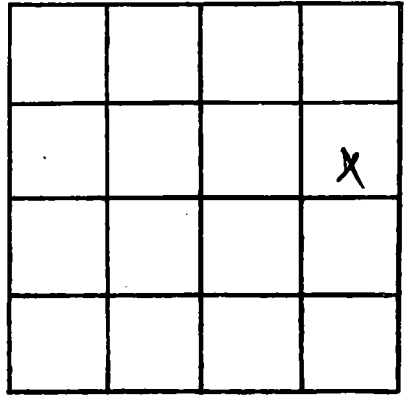

SECTION 6

Please indicate well location X.

ADDITIONAL INFORMATION

If more than one screen,
show locations of each on sketch.