

MISSISSIPPI DEPARTMENT OF NATURAL RESOURCES

Bureau of Land and Water Resources

Southport Mall

P.O. Box 10631

Jackson, Mississippi 39209 **CODED**

WATER WELL DRILLERS LOG

Jackson
P 414
4-12-85

4-12-85 19 *Coast Water Well Serv.* *Jackson*
date well completed firm name county well located

LANDOWNER: *Norm James*
3403 Laurel Ave
Pascagoula Miss
(mailing address) *39567*

description of formations encountered	from	to
<i>Top soil</i>	<i>0</i>	<i>3'</i>
<i>sand</i>	<i>3'</i>	<i>18'</i>
<i>Blue Clay (w/ shell)</i>	<i>18'</i>	<i>55'</i>
<i>sand</i>	<i>55'</i>	<i>70'</i>
<i>Blue Clay</i>	<i>70'</i>	<i>74'</i>
<i>sand</i>	<i>74'</i>	<i>90'</i>
<i>sand & gravel</i>	<i>90'</i>	<i>105'</i>

WELL LOCATION:
sec. *8* T. *8*/_S R. *6* E
IN miles of *Pascagoula*
(distance) (direction) (nearest town)

WELL PURPOSE: *Home*
(home, irrigation, municipal, industrial)

WELL COMPLETION DATA:

(1) diameter (inches) *2"*
(2) total depth (feet) *105'*
(3) static water level (feet) *20'* below top of ground.
(4) casing *PVC*, *95'*
(material) (depth)
2" if telescope see back.
(size)
(5) screen *10'*, *95'*
(length) (depth to top)
2", *PVC*
(size) (material)
(6) pump _____ (HP) _____ (yield gpm)
(type power)
(7) electric log *No*
(yes or no)
(organization running log)
(8) how well bottom plugged *Back Work Valve*


DRILLERS REMARKS:

RECEIVED
JUL 11 1985

Department of Natural Resources
Bureau of Land & Water Resources

If well telescopes please sketch and show depths.

GROUND LEVEL

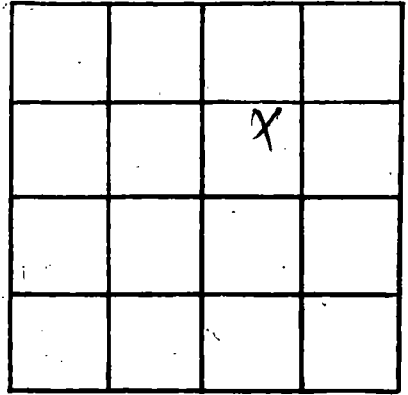

SECTION 8

Please indicate well location X.

ADDITIONAL INFORMATION

If more than one screen,
show locations of each on sketch.