

MISSISSIPPI DEPARTMENT OF NATURAL RESOURCES

Bureau of Land and Water Resources

Southport Mall

P.O. Box 10631

Jackson, Mississippi 39209

WATER WELL DRILLERS LOG

CODED

JACKSON  
#1 P415

12-3-85 Coast Water Well Jackson  
date well completed firm name county well located

LANDOWNER: Prince Howard  
Escatawpa, MS.  
(mailing address)

description of formations encountered	from	to
	Top Soil	0'
Blue Clay	5'	50'
White Coarse Sand	50'	75'

WELL LOCATION:  
sec. 2 T. 7<sub>S</sub> R. 6 E  
1 miles N of ESCATAWPA  
(distance) (direction) (nearest town)

WELL PURPOSE: ~~irrigation~~  
(home, irrigation, municipal/Industrial)

WELL COMPLETION DATA:

(1) diameter (inches) 4"

(2) total depth (feet) 75'

(3) static water level (feet) 12' below top of ground.

(4) casing (material) (depth) 75'

4" (size) If telescope see back.

(5) screen (length) (depth to top) 20' 75'

4" (size) PVC (material)

(6) pump (HP) (yield gpm) 2 85

Elect (type power)

(7) electric log No (yes or no)

(organization running log)

(8) how well bottom plugged Backwood Valve

CODED


RECEIVED  
FEB -7 1986

Department of Natural Resources  
Bureau of Land & Water Resources

DRILLERS REMARKS:

If well telescopes please sketch and show depths.

GROUND LEVEL

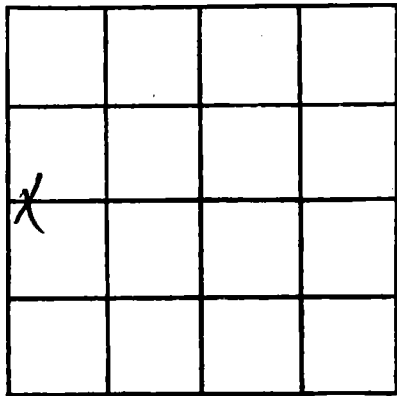

SECTION 2

Please indicate well location X.

ADDITIONAL INFORMATION

If more than one screen, show locations of each on sketch.