

MISSISSIPPI DEPARTMENT OF NATURAL RESOURCES

Bureau of Land and Water Resources

Southport Mall

P.O. Box 10631

Jackson, Mississippi 39209

WATER WELL DRILLERS LOG

CODED

JACKSON
#2 - P 4/16

12-3-85
date well completed

Coast & Water Well Sew. Jackson
firm name county well located

LANDOWNER: Benice Howard
Escatawpa, MS.
(mailing address)

description of formations encountered	from	to
Top soil	0	5'
Blue Clay	3'	50'
White Coquina sand 7' gravel	50'	75'

WELL LOCATION:
sec. 2 T. 7 N. R. 6 W.
1 miles N of ESCATAWPA
(distance) (direction) (nearest town)

WELL PURPOSE: Municipal
(home, irrigation, municipal, industrial)

- WELL COMPLETION DATA:
- (1) diameter (inches) 4"
 - (2) total depth (feet) 75'
 - (3) static water level (feet) 12' below top of ground.
 - (4) casing GALV (material), 75' (depth), 4" (size) if telescope see back.
 - (5) screen 20' (length), 75' (depth to top), 1/4" (size), PVC (material)
 - (6) pump 2 (HP), 85 (yield gpm), Elect (type power)
 - (7) electric log No (yes or no)
(organization running log)
 - (8) how well bottom plugged Backward Valve

CODED

RECEIVED


FEB 1986

Department of Natural Resources
Bureau of Land & Water Resources

DRILLERS REMARKS:

If well telescopes please sketch and show depths.

GROUND LEVEL

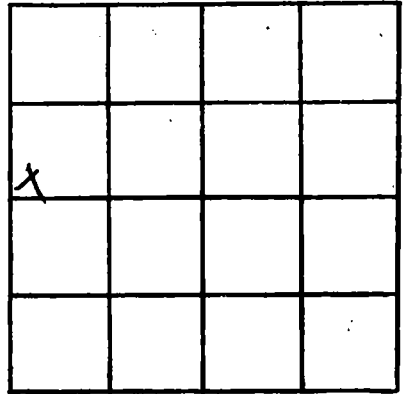

SECTION 2

Please indicate well location X.

ADDITIONAL INFORMATION

If more than one screen,
show locations of each on sketch.