

Jackson
P417

MISSISSIPPI DEPARTMENT OF NATURAL RESOURCES

Bureau of Land and Water Resources

Southport Mall

P.O. Box 10631

CODED

Jackson, Mississippi 39209

WATER WELL DRILLERS LOG

5-29-86

Coast water well

Jackson

date well completed

firm name

county well located

LANDOWNER:

Henry Lee

1204 DeLaPoint

Gautier MS

(mailing address)

WELL LOCATION:

sec. 31 T. 7 N. R. 6 E.

1 N miles of GAUTIER
(distance) (direction) (nearest town)

WELL PURPOSE:

Home
(home, irrigation, municipal, industrial)

WELL COMPLETION DATA:

- (1) diameter (inches) 2"
(2) total depth (feet) 1037'
(3) static water level (feet) 40' below top of ground.

- (4) casing PVC 1037'
(material) (depth)

2" If telescope see back.
(size)

- (5) screen 15' 1037'
(length) (depth to top)

2" PVC
(size) (material)

- (6) pump 1 (HP) 8 1/2 (yield gpm)

Elec
(type power)

- (7) electric log NO
(yes or no)

(organization running log)

- (8) how well bottom plugged backwash valve

DRILLERS REMARKS:

5'-2" PVC tailpipe

description of formations encountered

from

to


Top Soil	0	5
Red clay	5	10
Blue clay	10	32
Blue Clay + Clam Shell	32	45
White Coarse Sand + Wb	45	90
Blue Clay	90	130
Blue Clay + Oyster Shell	130	191
Blue Clay + Streak of Sand	191	211
Gray Coarse Sand	211	280
Gray Coarse Sand + Gravel	280	324
Blue clay	324	384
Blue Fine Sand	384	390
Blue Clay	390	450
Blue Clay + Oyster Shell	450	505
Blue Clay	505	520
Blue Clay + Streak of Sand	520	535
Blue Clay	535	676
Gray Fine Sand	676	699
Blue Clay	699	1000
Blue Clay + Streak of Sand	1000	1035
Gray Coarse Sand	1035	1052
Blue Clay	1052	1057

RECEIVED
JUL 18 1986

Department of Natural Resources
Bureau of Land & Water Resources

If well telescopes please
sketch and show depths.

GROUND LEVEL

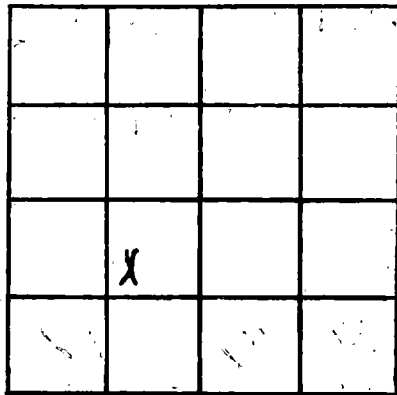

SECTION 31

Please indicate well location X.

ADDITIONAL INFORMATION

If more than one screen,
show locations of each on sketch.