

MISSISSIPPI DEPARTMENT OF NATURAL RESOURCES
Bureau of Land and Water Resources

P.O. Box 10631
Jackson, Mississippi 39209
WATER WELL DRILLERS LOG

COUNTY WELL LOCATED Jackson	
WELL NUMBER P 420	CODED
DATE WELL COMPLETED 5-28-87	

PERMIT NUMBER
NAME OF DRILLING FIRM Coast Water Well Service

CODED

NAME & MAILING ADDRESS OF LANDOWNER Moss Point Glove JEFFERSON ST. Moss Point, Ms.			
WELL LOCATION:	SEC 36	TOWNSHIP 7 N S 6 W	RANGE
DISTANCE 1/2	DIRECTION IN	NEAREST TOWN Miles — of Moss Point	
OTHER LANDMARK			
WELL PURPOSE: Home, Irrigation, Municipal, Industrial, Fish Pond, etc.			

PUMP DATA		
PUMP TYPE (Circle One): Submersible , Turbine, Jet, Flowing Well, Other (Describe) _____		
POWER TYPE (Circle One): Electric , Tractor, Diesel, Gasoline, Butane, Other (Describe) _____		
Pump Capacity (GPM) 35	No. of Stages 7	Setting Depth 147 FT.
PUMP TEST		
Well yielded _____ GPM with a drawdown of _____ ft. after _____ hours of pumping		

WELL DATA		
Well Depth 322'	Casing Diameter (In.) 4"	Casing Length (Ft.) 302'
Type of Casing PVC	Hole Depth 322'	Depth to Static Water Level 7.5
TYPE OF COMPLETION: (Circle One or More): Natural Development , Gravel Packed, Underreamed, Telescoped, Open Hole, Other (Describe) _____		
Top of Lap Pipe or Reduction in Casing FEET IF TELESCOPED OR MORE THAN ONE SCREEN: USE BACK PAGE		

LOG DATA	
TYPE OF LOG RUN (Circle One): No Log Run , Electric, Gamma Ray, Density, Sonic, Neutron, Other (Describe) _____	
Name of Organization Running Log	

SCREEN DATA		
Diameter - Inches 4"	Length - Feet 20'	Slot Size - Inches .008
Screen Type PVC	Depth to Bottom - Feet 322'	

GEOLOGIC DATA (Office Use Only)			
Surface Elev.	Geologic Unit	Unit Thickness	Depth to Top
Subs. SWL	Date	Analysis	Aquifer Test


Driller's Remarks

DESCRIPTION OF FORMATIONS ENCOUNTERED	FROM	TO
Jep Soil	0	2
Brown Sand	2	10
Blue Clay	10	60
Gray Coarse Sand	60	180
Gravel		
Blue Clay	180	280
Med Gray Sand	280	300
Gray Coarse Sand	300	322

RECEIVED	
SEP 21 1987	
Department of Natural Resources Bureau of Land & Water Resources	
IF MORE SPACE IS NEEDED, USE BACK	

If well telescopes please sketch and show depths.

GROUND LEVEL

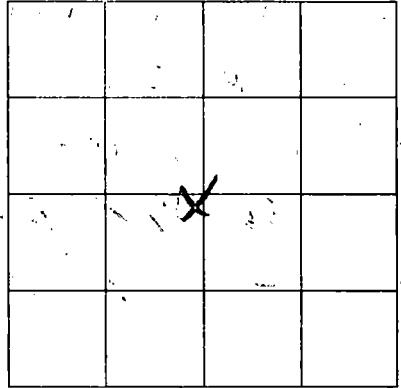

SECTION 36

Please indicate well location X.

ADDITIONAL INFORMATION

Ruled area for additional information.

If more than one screen,
show location of each on sketch.