

add loc pump pump
MISSISSIPPI DEPARTMENT OF NATURAL RESOURCES
 Bureau of Land and Water Resources

P.O. Box 10631
 Jackson, Mississippi 39209
WATER WELL DRILLERS LOG

COUNTY WELL LOCATED	
Jackson	
WELL NUMBER 421	CODED <input checked="" type="checkbox"/>
DATE WELL COMPLETED 11/13/87	

PERMIT NUMBER GW 7935
NAME OF DRILLING FIRM Coastwater Well Service

NAME & MAILING ADDRESS OF LANDOWNER Concrete Products Pascagoula, Ms			
WELL LOCATION:	SEC	TOWNSHIP	RANGE
NOT AVAIL.	3	N (S)	6 (W)
DISTANCE	DIRECTION	NEAREST TOWN	
_____ Miles	_____ of _____		
OTHER LANDMARK 480 FT. EAST OF INYALLS ACCESS Rd.			
WELL PURPOSE: Home, Irrigation, Municipal, Industrial, Fish Pond, etc. 1/2 - 3/4 MI SOUTH OF US HWY 90			

PUMP DATA		
PUMP TYPE (Circle One): Submersible , Turbine, Jet, Flowing Well, Other (Describe) _____		
POWER TYPE (Circle One): Electric , Tractor, Diesel, Gasoline, Butane, Other (Describe) _____		
Pump Capacity (GPM) 225	No. of Stages 7	Setting Depth 105' FT.
PUMP TEST		
Well yielded 300 GPM with a drawdown of 25' ft. after 7 hours of pumping		

WELL DATA		
Well Depth 300'	Casing Diameter (In.) 2 1/2"	Casing Length (Ft.) 270'
Type of Casing PVC	Hole Depth 300'	Depth to Static Water Level 25'
TYPE OF COMPLETION: (Circle One or More): Natural Development , Gravel Packed, Underreamed, Telescoped, Open Hole, Other (Describe) _____		
Top of Lap Pipe or Reduction in Casing		
FEET	IF TELESKOPED OR MORE THAN ONE SCREEN: USE BACK PAGE	

LOG DATA	
TYPE OF LOG RUN (Circle One): Electric, Gamma Ray, Density, Sonic, No Log Run , Other (Describe) _____	
Name of Organization Running Log	

- SCREEN DATA		
Diameter - Inches 6"	Length - Feet 30'	Slot Size - Inches 0.10
Screen Type PVC	Depth to Bottom - Feet 300'	

GEOLOGIC DATA (Office Use Only)			
Surface Elev.	Geologic Unit	Unit Thickness	Depth to Top
Subs. SWL	Date	Analysis	Aquifer Test
Driller's Remarks WELL NOT BEING USED (CAPPED) 5/37/88			

RECEIVED

DESCRIPTION OF FORMATIONS ENCOUNTERED	FROM	TO	FORMATIONS (CONTINUED)	
			FROM	TO
Top Soil	0	6		
White Coars Sand	6	20'		
Blue Clay	20'	40'		
Gray Coars Sand				
Gravel	40	95'		
Blue Clay	95	149'		
Gray Coars Sand	149'	180'		
Blue Clay	180	184'		
Gray Coars Sand	184'	196'		
Blue Clay	196'	210'		
Gray Coars Sand	210'	300'		


MAY 24 1988

Department of Natural Resources
 Bureau of Land & Water Resources

IF MORE SPACE IS NEEDED, USE BACK

If well telescopes please sketch and show depths.

GROUND LEVEL

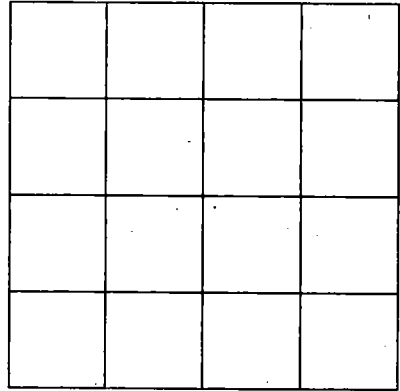

SECTION _____

Please indicate well location X.

ADDITIONAL INFORMATION

If more than one screen, show location of each on sketch.