

MISSISSIPPI DEPARTMENT OF NATURAL RESOURCES

Bureau of Land and Water Resources

Southport Mall

P.O. Box 10631

Jackson, Mississippi 39209

WATER WELL DRILLERS LOG

Jackson
 P 424
 CODED

5-28-88
 date well completed

firm name

Jackson
 county well located

LANDOWNER: *Mr Walker*
22 1st St
Osageola
 (mailing address)

description of formations encountered

from

to

<i>Sandy soil</i>	<i>0</i>	<i>25</i>
<i>Sandy clay</i>	<i>25</i>	<i>40</i>
<i>clay</i>	<i>40</i>	<i>65</i>
<i>sand</i>	<i>65</i>	<i>85</i>

WELL LOCATION:

sec. 7 T. N R. 6 E
City of Osageola
 (distance) (direction) (nearest town)

WELL PURPOSE:
 (home, irrigation, municipal, industrial)

WELL COMPLETION DATA:

- (1) diameter (inches) 2"
- (2) total depth (feet) 85'
- (3) static water level (feet) 20 ^{below} _{above} top of ground.
- (4) casing PVC 80
 (material) (depth)
 (size) if telescope see back.
- (5) screen 5 80
 (length) (depth to top)
2" PVC
 (size) (material)
- (6) pump 1 12
 (HP) (yield gpm)
AC
 (type power)
- (7) electric log N
 (yes or no)
 (organization running log)
- (8) how well bottom plugged BWV

RECEIVED


JUN 08 1988

Department of Natural Resources
 Bureau of Land & Water Resources

DRILLERS REMARKS:

If well telescopes please sketch and show depths.

GROUND LEVEL

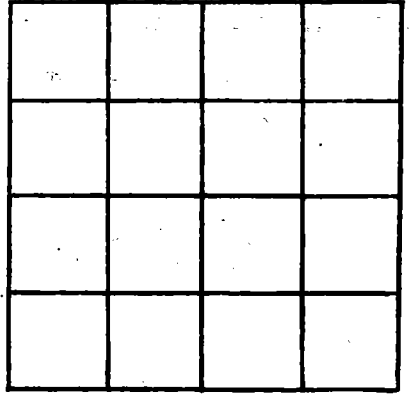

SECTION _____

Please indicate well location X.

ADDITIONAL INFORMATION

If more than one screen,
show locations of each on sketch.