

MISSISSIPPI DEPARTMENT OF NATURAL RESOURCES

Bureau of Land and Water Resources

Southport Mall

P.O. Box 10631

Jackson, Mississippi 39209

WATER WELL DRILLERS LOG

Falcon
P 425
CODED

6/2/88 date well completed Latham well Co firm name Jackson county well located

LANDOWNER:	description of formations encountered	from	to
<u>Mrs. M. B. ...</u> <u>Monticello St</u> <u>Mon. Point MS</u> (mailing address)	<u>sand</u> <u>clay</u> <u>sand</u>	<u>0</u> <u>25</u> <u>30</u>	<u>25</u> <u>30</u> <u>40</u>
WELL LOCATION:			
sec. <u>7</u> T <u>N</u> R <u>6</u> E			
<u>City of Mon. Point</u> (distance) (direction) (nearest town)			
WELL PURPOSE: (home, irrigation, municipal, industrial)			
WELL COMPLETION DATA:			
(1) diameter (inches) <u>2"</u>			
(2) total depth (feet) <u>40</u>			
(3) static water level (feet) <u>10</u> <u>below</u> above top of ground.			
(4) casing <u>PVC</u> <u>35'</u> (material) (depth)			
_____ if telescope see back. (size)			
(5) screen <u>5'</u> <u>35'</u> (length) (depth to top)			
<u>2"</u> <u>PVC</u> (size) (material)			
(6) pump <u>1/2</u> <u>8</u> (HP) (yield gpm)			
<u>AL</u> (type power)			
(7) electric log (yes or no) _____			
_____ (organization running log)			
(8) how well bottom plugged <u>DW/V</u>			
DRILLERS REMARKS:			


RECEIVED

JUN 08 1988

Department of Natural Resources
 Bureau of Land & Water Resources

If well telescopes please sketch and show depths.

GROUND LEVEL

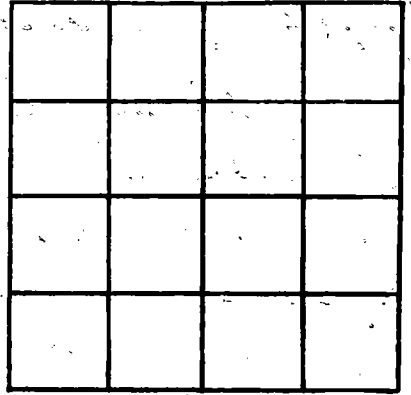

SECTION _____

Please indicate well location X.

ADDITIONAL INFORMATION

If more than one screen,
show locations of each on sketch.