

MISSISSIPPI DEPARTMENT OF NATURAL RESOURCES

Bureau of Land and Water Resources

Southport Mall

P.O. Box 10631

Jackson, Mississippi 39209

WATER WELL DRILLERS LOG

Jackson  
P427  
CODED

7-12-88  
date well completed

Robert W. W. W.  
firm name

Jackson  
county well located

LANDOWNER: <u>Mr. Furseman</u>	description of formations encountered	from	to
<u>10th St</u>	<u>sandy soil</u>	0	30
<u>Baseoganda ma</u> (mailing address)	<u>clay</u>	30	45
WELL LOCATION:	<u>sandy clay</u>	45	60
sec. <u>10</u> T. <u>7</u> N. <u>S</u> R. <u>6</u> E. <u>W</u>	<u>sand</u>	60	75
(distance) miles (direction) of (nearest town)			
WELL PURPOSE: <u>Municipal</u> (home, irrigation, municipal, industrial)			
WELL COMPLETION DATA:			
(1) diameter (inches) <u>2"</u>			
(2) total depth (feet) <u>70'</u>			
(3) static water level (feet) <u>20</u> <sup>below</sup> above top of ground.			
(4) casing <u>PVC</u> , <u>65'</u> (material) (depth)			
<u>2"</u> (size) If telescope see back.			
(5) screen <u>5'</u> , <u>65'</u> (length) (depth to top)			
<u>2"</u> , <u>PVC</u> (size) (material)			
(6) pump <u>1/2</u> <u>8</u> (HP) (yield gpm)			
<u>A/C</u> (type power)			
(7) electric log <u>N/A</u> (yes or no)			
(organization running log)			
(8) how well bottom plugged <u>B/W</u>			
DRILLERS REMARKS:			


RECEIVED

AUG 04 1988

Department of Natural Resources  
Bureau of Land & Water Resources

If well telescopes please sketch and show depths.

GROUND LEVEL

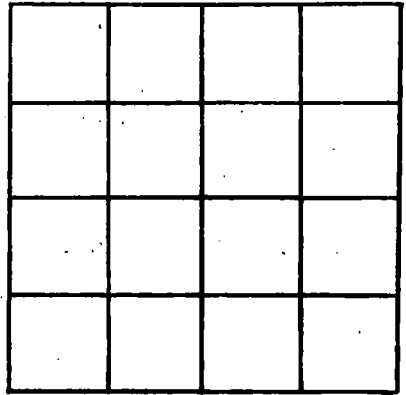

SECTION \_\_\_\_\_

Please indicate well location X.

ADDITIONAL INFORMATION

If more than one screen,  
show locations of each on sketch.