

MISSISSIPPI DEPARTMENT OF NATURAL RESOURCES

Bureau of Land and Water Resources

COUNTY WELL LOCATED
TACKSON
 WELL NUMBER **P 433** CODED
 DATE WELL COMPLETED
8-10-89

39513
 PERMIT NUMBER
 NAME OF DRILLING FIRM
Coastal Water Well Dr. Inc.

CODED

P.O. Box 10631
 Jackson, Mississippi 39209
WATER WELL DRILLERS LOG

NAME & MAILING ADDRESS OF LANDOWNER
Wanderland Coop
P.O. Box 516
Gautier, Mo. 39553
 WELL LOCATION: SEC **7** TOWNSHIP **7** RANGE **6**
S N E W
 DISTANCE **2** Miles DIRECTION **N** of NEAREST TOWN **GAUTIER**
 OTHER LANDMARK
 WELL PURPOSE: Home, Irrigation, Municipal, Industrial, Fish Pond, etc.
Recreational Use

PUMP DATA
 PUMP TYPE (Circle One):
 Submersible, Turbine, Jet, Flowing Well,
 Other (Describe) _____
 POWER TYPE (Circle One):
 Electric, Tractor, Diesel, Gasoline, Butane,
 Other (Describe) _____
 Pump Capacity (GPM) _____ No. of Stages _____ Setting Depth _____ FT.
 PUMP TEST: *None*
 Well yielded _____ GPM with
 a drawdown of _____ ft.
 after _____ hours of pumping

WELL DATA
 Well Depth **265'** Casing Diameter (In.) **4"** Casing Length (Ft.) **245'**
 Type of Casing **PVC** Hole Depth **265'** Depth to Static Water Level _____
 TYPE OF COMPLETION: (Circle One or More):
 Gravel Packed, Underreamed, Telescoped,
 Natural Development, Open Hole, Other
 (Describe) _____
 Top of Lap Pipe or Reduction in Casing _____
 FEET IF TELESCOPED OR MORE THAN ONE SCREEN: USE BACK PAGE

LOG DATA
 TYPE OF LOG RUN (Circle One): No Log Run,
 Electric, Gamma Ray, Density, Sonic, Neutron,
 Other (Describe) _____
 Name of Organization Running Log _____

SCREEN DATA
 Diameter - Inches **4"** Length - Feet **20'** Slot Size - Inches **.008**
 Screen Type **PVC** Depth to Bottom - Feet **245'**

GEOLOGIC DATA (Office Use Only)

Surface Elev.	Geologic Unit	Unit Thickness	Depth to Top
Subs. SWL	Date	Analysis	Aquifer Test


Driller's Remarks

DESCRIPTION OF FORMATIONS ENCOUNTERED	FROM	TO	FORMATIONS (Continued)	FROM	TO
<i>Top soil</i>	<i>0</i>	<i>5</i>			
<i>Red clay</i>	<i>5</i>	<i>15</i>			
<i>Fine sand</i>	<i>15</i>	<i>25</i>			
<i>Gray clay / shaly sand</i>	<i>25</i>	<i>65</i>			
<i>Fine to med. sand</i>	<i>65</i>	<i>125</i>			
<i>Blue clay</i>	<i>125</i>	<i>185</i>			
<i>Fine blue sand</i>	<i>185</i>	<i>215</i>			
<i>Med. sand</i>	<i>215</i>	<i>245</i>			
<i>Coarse sand</i>	<i>245</i>	<i>268</i>			

IF MORE SPACE IS NEEDED, USE BACK

If well telescopes please sketch and show depths.

GROUND LEVEL

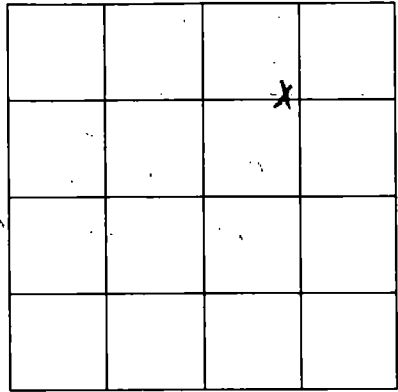

SECTION 7

Please indicate well location X.

ADDITIONAL INFORMATION

If more than one screen,
show location of each on sketch.