

MISSISSIPPI DEPARTMENT OF ENVIRONMENTAL QUALITY

Office of Land and Water Resources

P. O. Box 10631
Jackson, MS 39289-0631
WATER WELL DRILLERS LOG

COUNTY WELL LOCATED Jackson		PERMIT NUMBER
WELL NUMBER P454	CODED <input checked="" type="checkbox"/>	NAME OF DRILLING FIRM Coast Water Well Service
DATE WELL COMPLETED 4-23-96		

NAME & MAILING ADDRESS OF LANDOWNER Sidney Ross Griffin Street Miss Point Ms			
WELL LOCATION	SEC	TOWNSHIP	RANGE
	10	7^N	6^W
DISTANCE	DIRECTION	NEAREST TOWN	
1/2	N	MISS POINT	
OTHER LANDMARK LAST HOUSE ON RT. GRIFFIN ST			
WELL PURPOSE: Home Irrigation, Municipal, Industrial, Fish Pond, etc.			

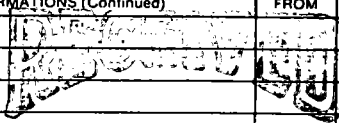
PUMP DATA		
PUMP TYPE (Circle One): <u>Submersible</u> Turbine, Jet, Flowing Well, Other (Describe) _____		
POWER TYPE (Circle One): <u>Electric</u> Tractor, Diesel, Gasoline, Butane, Other (Describe) _____ H/P 2		
Pump Capacity (GPM) 35	No. of Stages 7	Setting Depth 80' FT.
PUMP TEST		
Well yielded _____ GPM with a drawdown of _____ ft. after _____ hours of pumping		

WELL DATA		
Well Depth 210'	Casing Diameter (In.) 4"	Casing Length (Ft.) 200'
Type of Casing PVC	Hole Depth 212'	Depth to Static Water Level 30'
TYPE OF COMPLETION: (Circle One or More): Gravel Packed, Underreamed, Telescoped, <u>Natural Development</u> Open Hole, Other		
WELL GROUTED TO A DEPTH OF 20 FEET Type Grout (circle one): Cement, <u>Bentonite</u> , or Mix		

LOG DATA	
TYPE OF LOG RUN (Circle One): Electric, Gamma Ray, Density, Sonic, <u>No Log Run</u> , Neutron, Other (Describe) _____	
Name of Organization Running Log	

SCREEN DATA		
Diameter - Inches 4"	Length - Feet 10'	Slot Size - Inches .008
Screen Type PVC	Depth to Bottom - Feet 210'	

GEOLOGIC DATA (Office Use Only)			
Surface Elev.	Geologic Unit	Unit Thickness	Depth to Top
Subs. SWL	Date	Analysis	Aquifer Test
Driller's Remarks			
Top of Lap Pipe or Reduction in Casing			
FEET IF TELESKOPED OR MORE THAN ONE SCREEN: USE BACK PAGE			

DESCRIPTION OF FORMATIONS ENCOUNTERED	FROM	TO	FORMATIONS (Continued)	FROM	TO
Top Soil	0	5	 MAY 24 1996 Dept. of Environmental Quality Office of Land & Water Resources		
Black Mud grey clay	5	20			
Coarse sand	20	30			
Orange grey clay	30	45			
Coarse sand peagritue	45	110			
Blue Clay	110	155			
Med sand streaked clay	155	180			
Blue Clay	180	190			
Coarse sand	190	212			

IF MORE SPACE IS NEEDED, USE BACK

If well telescopes please sketch and show depths.

GROUND LEVEL

	X		

SECTION 10

Please indicate well location X.

ADDITIONAL INFORMATION

If more than one screen, show location of each on sketch.