

MISSISSIPPI DEPARTMENT OF ENVIRONMENTAL QUALITY

Office of Land and Water Resources

P. O. Box 10631
Jackson, MS 39289-0631

WATER WELL DRILLERS LOG

COUNTY WELL LOCATED Jackson	
WELL NUMBER SW2-A	CODED
P-462	
DATE WELL COMPLETED 04-22-03	

PERMIT NUMBER
NAME OF DRILLING FIRM Fugro Geosciences, Inc.
6105 Rookin, Houston, TX 77074

NAME & MAILING ADDRESS OF LANDOWNER W.P. Harrison			
P.O. Box 1288			
Social Circle, GA 72202			
WELL LOCATION	SEC	TOWNSHIP	RANGE
Gautier	6	8	N 6 E
DISTANCE	DIRECTION		NEAREST TOWN
.5	Miles SW		of Gautier
OTHER LANDMARK Hwy. 90 and Pascagoula River Intersection			
WELL PURPOSE Home, Irrigation, Municipal, Industrial, Fish Pond, etc.			
Monitoring			

PUMP DATA		
PUMP TYPE (Circle One): Submersible, Turbine, Jet, Flowing Well, Other (Describe) N/A		
POWER TYPE (Circle One): Electric, Tractor, Diesel, Gasoline, Butane, Other (Describe) N/A H/P _____		
Pump Capacity (GPM) N/A	No. of Stages N/A	Setting Depth N/A FT.
PUMP TEST		
Well yielded N/A GPM with a drawdown of N/A ft. after N/A hours of pumping		

WELL DATA		
Well Depth 40	Casing Diameter (In) 2	Casing Length (Ft) 30
Type of Casing PVC	Hole Depth 40	Depth to Static Water Level 7 ft.

LOG DATA	
TYPE OF LOG RUN (Circle One): Electric, Gamma Ray, Density, Sonic, Neutron, Other (Describe) N/A No Log Run.	
Name of Organization Running Log	

TYPE OF COMPLETION: (Circle One or More):
 Gravel Packed, Underreamed, Telescoped,
 Natural Development, Open Hole, Other
 (Describe) _____

GEOLOGIC DATA (Office Use Only)			
Surface Elev.	Geologic Unit	Unit Thickness	Depth to Top
Subs. SWL	Date	Analysis	Aquifer Test

WELL GROUTED TO A DEPTH OF **26 FEET**
 Type Grout (circle one): Cement, Bentonite, or **Mix**

Driller's Remarks Bentonite Seal 26-28 Ft.	
Top of Lap Pipe or Reduction in Casing N/A FEET	
IF TELESCOPED OR MORE THAN ONE SCREEN, USE BACK PAGE	


SCREEN DATA		
Diameter - Inches 2	Length - Feet 10	Slot Size - Inches 0.010
Screen Type PVC		Depth to Bottom - Feet 40

DESCRIPTION OF FORMATIONS ENCOUNTERED	FROM	TO
Poorly Sorted Sands	0	10
Silty Clay	10	30
Poorly Sorted Sands (tightly compacted)	30	40

FORMATIONS (Continued)	FROM	TO
RECEIVED		
JUN 23 2003		
BY: OLWR		
IF MORE SPACE IS NEEDED, USE BACK		

If well telescopes please
sketch and show depths.

GROUND LEVEL

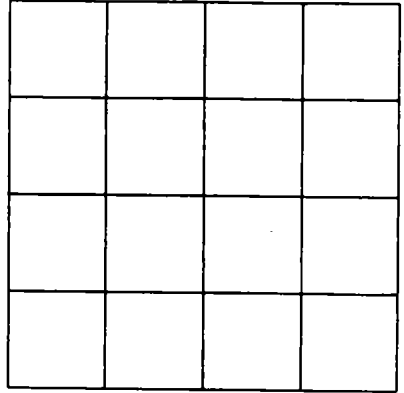

SECTION _____

Please indicate well location X.

ADDITIONAL INFORMATION

If more than one screen,
show location of each on sketch.