County: <u>Jackson</u> Permit #: Driller. <u>CastWaterWells</u> RV. P.O. B Jackson, M Date drilling completed: <u>8-4-C6</u> (601)354	nd Water Resources ox 10631 S 39289-0631 D61-5210 I-6938 (fax)	For Office Use Only:	
State Law requires that this report be prepared by the 30 days of completion of drilling of the well.			
Well Owner Information	Well Lo	ocation	
Owner Name LOUIS FONdren	Latitude: <u>30 • 25 • 047</u> "	Longitude: <u>088.37 · 190</u> ."	
Mailing Address: 704 Homestead Blvd.	Method of Lat/Long (circle one):		
	USGS quad, (Hand-held GF		
Gaufier MS 39553 City State Zip Code	St 1/ SE 1/ Sec 7 V	Twn $\underline{\mathcal{T}75^{\vee}RngR6^{\omega}}$	
Telephone No. 228 497 - 0029	Distance Direction	Nearest Town CANTEN	
Well I	Jata		
Purpose of Well (circle one) Home Industrial Public Supply Irrigation Fish Culture Other:			
Date well drilling started: 8-4-06 Date w			
If flowing, method of flow regulation: Valve N/A . Other (de		1	
Static Water Level:feet above or below (circle one) la	and surface Date measured:	8-4-06	
Method of Measurement (circle one) steel tape electric tape	\sim	·	
Hole depth: <u>55'</u> Well depth: <u>55'</u>	Well grouted to a depth of	10 feet	
Type of grout (circle one): Cement Bentonite Mix			
Casing length: <u>45</u> feet Casing diameter: <u>2</u>	_inches Type of casing:	°VC	
Screen length: 10_feet Screen diameter: 3	inches Type of screen:	NC	
Screen slot size: <u></u>	<u>45</u> feet to <u>55</u>	5feet	
Type of completion (circle all applicable): Gravel packed Under	reamed Telescoped Open ho	le Natural Development	
Other (describe):			
Top of lap pipe or reduction in casing:	escoped or more than one screen	, describe on back of page	
Logs run (circle all applicable): No log run Electric Gamma Ray	Density Sonic Neutron Otl	ner:	
Name of organization running log(s): N/A			
I certify that the well was drilled, constructed, and completed in a Department of Environmental Quality and/or the Mississippi Dep	••	• ••	
Tack Ridadall 0	auch / ha	RECEIVED	
Print Name of Water Well Contractor and License No.	Signature of W	ater Well Contractor 2 9 2003	

•


BY: OLWR

P-475

If well telescopes please sketch below and show depths.

Ground Level	Description of Formations Encountered From	<u>To</u>
	TopSoil	
	Brown Clay	a
	White Coarse Sand 2:	555
		_
		_

If more than one screen, show location of each on sketch

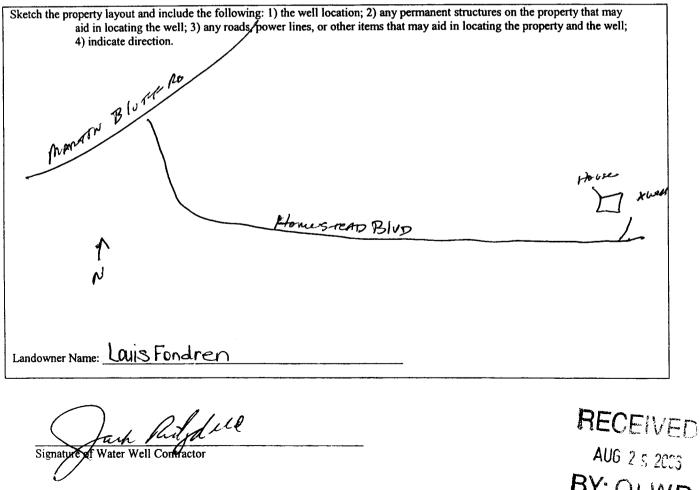

AUG 2 5 2003 BY: OLWR