

JACKSON

P 2007

2/14/76

2/14

2/14

date well completed

MISSISSIPPI BOARD OF WATER COMMISSIONERS
416 North State Street
Jackson, Mississippi 39201

WATER WELL DRILLERS LOG

COAST WATER WELL SERVICE INC.

firm name

Jackson county well located

LANDOWNER: Sidney Malant
(mini warehouse)

description of formations encountered

from to

Red Clay

0 3

Hautier, Ms.
(mailing address)

Blue clay

3 22

WELL LOCATION:

sec 36 T 7 R 8
in Hautier
miles (distance) of (nearest town)

S + C

22 43

Blue clay

43 86

sand (c)

86 117

WELL PURPOSE: home
(home, irrigation, municipal, industrial)

Blue clay

117 172

WELL COMPLETION DATA:

sand (c)

172 181

(1) diameter (inches) 2"
(2) total depth (feet) 290'
(3) static water level (feet) 30' below top of ground.

Blue clay

181 210

sand med.

210 290

(4) casing PVC, 280' (material) (depth)
2" (size) If telescope see back.
(5) screen 10', 280' (length) (depth to top)
2" (size) PVC (material)

(6) pump (HP) (yield gpm)


(type power)

(7) electric log (yes or no)

(organization running log)

(8) how well bottom plugged b/w valve

DRILLERS REMARKS:

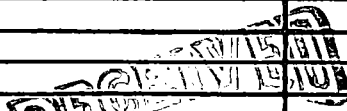


JUL - 1 1976

MISS. Bd. OF WATER COMMISSIONERS

If well telescopes please sketch and show depths.

GROUND LEVEL

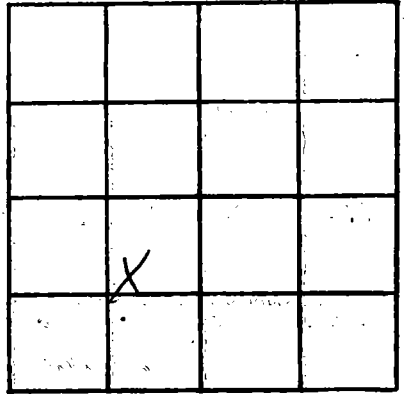

SECTION 36

Please indicate well location X.

ADDITIONAL INFORMATION

Multiple horizontal lines for additional information.

If more than one screen, show locations of each on sketch.

