

JACKSON

P 2008

MISSISSIPPI BOARD OF WATER COMMISSIONERS 416 North State Street Jackson, Mississippi 39201

WATER WELL DRILLERS LOG

5-1-78 date well completed

Coast Water Well Serv. Inc. firm name

Jackson county well located

LANDOWNER: T. A. Smith

description of formations encountered

from to

2802 Jefferson Ave Pascagoula Miss. (mailing address) 39567

Top soil	0	16
Blue Clay	16	50
Sand (C)	50	160
Blue Clay	160	270
Sand (M)	270	282
Blue Clay	282	292
Sand (MC)	292	310

WELL LOCATION:

sec 36 T 7 N R 6 E 1/4 miles (distance) (direction) (nearest town) Pascagoula


WELL PURPOSE: Home (home, irrigation, municipal, industrial)

WELL COMPLETION DATA:

- (1) diameter (inches) 2"
- (2) total depth (feet) 310'
- (3) static water level (feet) 75' below top of ground
- (4) casing PVC, 300' (material) (depth) 2" (size) If telescope see back.
- (5) screen 10' (length), 300' (depth to top) 2" (size), PVC (material)
- (6) pump 2 HP (HP), 10 (yield gpm) Elec. (type power)
- (7) electric log No. (yes or no)
- (organization running log)

(8) how well bottom plugged back wash blue


DRILLERS REMARKS:

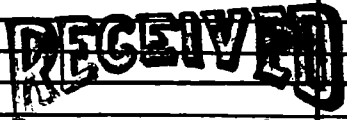

AUG - 3 1978

If well telescopes please sketch and show depths.

GROUND LEVEL

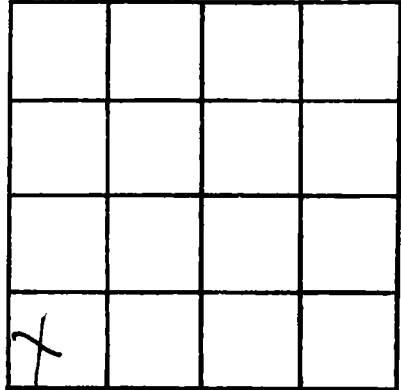

SECTION 36

Please indicate well location X.

ADDITIONAL INFORMATION

If more than one screen, show locations of each on sketch.