

MISSISSIPPI DEPARTMENT OF NATURAL RESOURCES

Bureau of Land and Water Resources

Southport Mall

P.O. Box 10631

Jackson, Mississippi 39209

WATER WELL DRILLERS LOG

Jackson
P2015

6-12-1984
date well completed

84 Cross & Water Well Saw.
firm name

Jackson
county well located

LANDOWNER: Thomas Singletary
Hators Plaza Suite 208
Passaway Miss.
(mailing address) 39267

description of formations encountered	from	to
Top soil	0	2'
Red Clay	2'	15'
Red fine sand	15'	18'
Blue Clay	18'	30'
Red coarse sand	30'	45'
Blue Clay	45'	57'
Gray Med. Sand	57'	130'
Blue Clay	130'	137'
Gray coarse sand	137'	253'
7 ft. Tail Pipe		Water

WELL LOCATION:

sec. 10 T 7 N R 6 E
IN miles of Mass Point
(distance) (direction) (nearest town)

WELL PURPOSE:

None
(home, irrigation, municipal, industrial)

WELL COMPLETION DATA:

- (1) diameter (inches) 4"
- (2) total depth (feet) well 255'
- (3) static water level (feet) 20' below top of ground.
- (4) casing PVC, 245' (material) (depth)
4" (size) If telescope see back.
- (5) screen 10' (length), 245' (depth to top)
4" (size) PVC (material)
- (6) pump 1/2 hp. Subm. 19 (HP) (yield gpm)
Elect. (type power)
- (7) electric log No. (yes or no)
(organization running log)

(8) How well bottom plugged
Back Wash Valve


DRILLERS REMARKS:

MISSISSIPPI DEPARTMENT OF NATURAL RESOURCES
BUREAU OF LAND & WATER RESOURCES

06/11/1984
RECEIVED

If well telescopes please sketch and show depths.

GROUND LEVEL

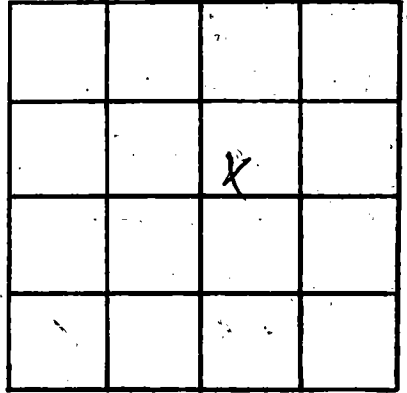

SECTION 10

Please indicate well location X.

ADDITIONAL INFORMATION

If more than one screen, show locations of each on sketch.