

**MISSISSIPPI DEPARTMENT OF NATURAL RESOURCES**  
**Bureau of Land and Water Resources**  
 Southport Mall  
 P.O. Box 10631  
 Jackson, Mississippi 39209  
**WATER WELL DRILLERS LOG**

Jackson  
P 2017

Aug. 20, 1985, 19 Coast water well Jackson  
 date well completed firm name county well located

**LANDOWNER:** Mass Point Glor  
P.O. Box 569  
Mass Point, Ms 39563  
 (mailing address)

**WELL LOCATION:**  
 sec 36 T 7 R 6  
IN miles of MASS POINT  
 (distance) (direction) (nearest town)

**WELL PURPOSE:** Commercial  
 (home, Irrigation, municipal, Industrial)

**WELL COMPLETION DATA:**

(1) diameter (Inches) 4"  
 (2) total depth (feet) 322'  
 (3) static water level (feet) 90 below top of ground.  
 (4) casing PVC, 295', CL  
 (material) (depth)  
4" If telescope see back.  
 (size)  
 (5) screen 20', 295'  
 (length) (depth to top)  
4" PVC  
 (size) (material)  
 (6) pump 2 h.p. 35  
 (HP) (yield gpm)  
Electric  
 (type power)  
 (7) electric log no  
 (yes or no)  
 (organization running log)  
 (8) how well bottom plugged Backward valve

description of formations encountered	from	to
Top Sand	0'	1'
Red Coarse Sand	1'	10'
Blue Clay & clam shells	10'	21'
Blue Clay-clam shells + wood	21'	60'
White Coarse sand	60'	176'
Blue Clay	176'	280'
Gray Coarse sand	280'	312'
Gray Coarse sand + Gravel	312'	322'
		Hole


**RECEIVED**  
 NOV - 4 1985

Department of Natural Resources  
 Bureau of Land & Water Resources

**DRILLERS REMARKS:**  
7'-2" tail pipe

If well telescopes please sketch and show depths.

GROUND LEVEL

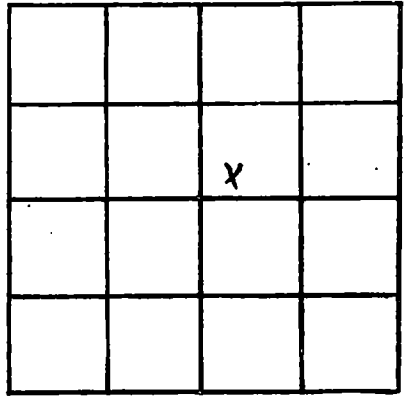

SECTION 36

Please indicate well location X.

ADDITIONAL INFORMATION

If more than one screen,  
show locations of each on sketch.