

MISSISSIPPI DEPARTMENT OF NATURAL RESOURCES

Bureau of Land and Water Resources

Southport Mall

P.O. Box 10631

Jackson, Mississippi 39209

WATER WELL DRILLERS LOG

JACKSON
P2080

7-24-86 19 Condwaterwell, Inc Jackson
date well completed firm name county well located

LANDOWNER: James Fannin
5206 Myrtle
Miss Point, MS
(mailing address) 39563

Description of formations encountered	from	to
Top Sand	0	11
Blue Clay	11	40
Red Concrete Sand	40	72
Red Concrete Sand and wood	72	74

WELL LOCATION:
sec 24 T 7 S R 6 E
1/4 miles of Miss Point
(distance) (direction) (nearest town)

WELL PURPOSE: Irrigation
(home, irrigation, municipal, industrial)

WELL COMPLETION DATA:

- (1) diameter (inches) 2"
- (2) total depth (feet) 74'
- (3) static water level (feet) 27' below top of ground
- (4) casing PVC, 64' (depth)
2" (size) if telescope see back.
- (5) screen 10' (length), 64' (depth to top)
2" (size), PVC (material)
- (6) pump 1 (HP), 10 (yield gpm)
Elect. (type power)
- (7) electric log no (yes or no)
(organization running log)
- (8) how well bottom plugged back wash


RECEIVED
AUG 26 1986

Department of Natural Resources
Bureau of Land & Water Resources

DRILLERS REMARKS:

If well telescopes please sketch and show depths.

GROUND LEVEL

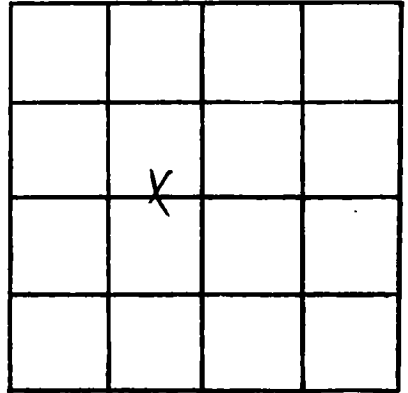

SECTION 24

Please indicate well location X.

ADDITIONAL INFORMATION

If more than one screen, show locations of each on sketch.