

Jackson
P2021
12-67

MISSISSIPPI
BOARD OF WATER COMMISSIONERS
416 North State Street
Jackson, Mississippi 39201

11

WATER WELL DRILLERS LOG

12-2-67 19 COAST WATER WELLS SERVICE JACKSON
date well completed firm name county well located

LANDOWNER: DR. LANE
PASCAGOULA (City)
(mailing address)

WELL LOCATION:
sec. 14 T 8 N R 6 E
miles 17 of Pascagoula
(distance) (direction) (nearest town)

WELL PURPOSE: Irrigation
(home, irrigation, municipal, industrial)


WELL COMPLETION DATA:

- (1) diameter (inches) 2 1/2
- (2) total depth (feet) 73'
- (3) static water level (feet) 10 ^{below} _{above} top of ground.
- (4) casing GALV. 63' ^{below} _{above}
(material) (depth)
- 2" If telescope see back.
(size)
- (5) screen 10' 63'
(length) (depth to top)
- 2" PLASTIC
(size) (material)
- (6) pump 1/2 10
(HP) (yield gpm)
- Elect.
(type power)
- (7) electric log NO
(yes or no)

(organization running log)

(8) how well bottom plugged 2' BACK
WASH VALVE

description of formations encountered	from	to
RED CLAY	0	15
FINE SAND	15	32
BLUE CLAY	32	41
MED. & COARSE SAND.	41	73

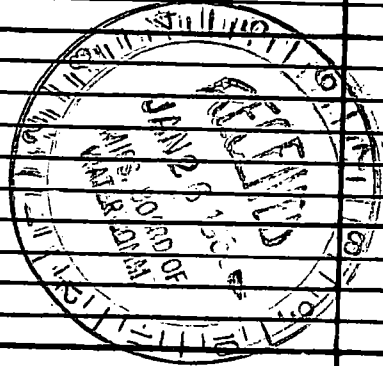

DRILLERS REMARKS:

If well telescopes please sketch and show depths.

GROUND LEVEL

	X		

SECTION 14

Please indicate well location X.

ADDITIONAL INFORMATION

If more than one screen, show locations of each on sketch.