

**JACKSON**  
**P 2023**  
**5-2-75**

**MISSISSIPPI**  
**BOARD OF WATER COMMISSIONERS**  
 416 North State Street  
 Jackson, Mississippi 39201

**WATER WELL DRILLERS LOG**  
**COAST WATER WELL SERVICE INC.**

5/2 1975      firm name Jackson      county well located

LANDOWNER: J. H. Johnston  
3717 Johnston Rd.  
Sauter Miss.  
 (mailing address)

description of formations encountered	from	to
	<u>top soil</u>	<u>0</u>
<u>clay</u>	<u>3</u>	<u>16</u>
<u>Sand (m)</u>	<u>16</u>	<u>26</u>
<u>clay</u>	<u>26</u>	<u>82</u>
<u>Sand (c)</u>	<u>82</u>	<u>145</u>
<u>clay</u>	<u>145</u>	<u>183</u>
<u>Sand (c)</u>	<u>183</u>	<u>270</u>
		<u>Hole</u>

WELL LOCATION:  
 sec. 31 T-7 R-6  
S in W  
 miles in of  
 (distance) (direction) (nearest town)

WELL PURPOSE: HOME  
 (home, irrigation, municipal, industrial)

- WELL COMPLETION DATA:
- diameter (inches) 2"
  - total depth (feet) well 270'
  - static water level (feet) 25 below top of ground.
  - casing PVC, 260' (depth)  
2" (size) if telescope see back.
  - screen 10', 260' (length) (depth to top)  
2" (size), PVC (material)
  - pump \_\_\_\_\_ (HP) \_\_\_\_\_ (yield gpm)  
 \_\_\_\_\_ (type power)
  - electric log NO (yes or no)  
 \_\_\_\_\_ (organization running log)
  - how well bottom plugged PVV


DRILLERS REMARKS:

APR - 8 1975

MISSISSIPPI BOARD OF WATER COMMISSIONERS

If well telescopes please sketch and show depths.

GROUND LEVEL

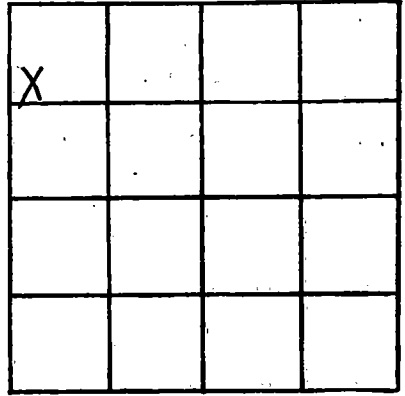

SECTION 31

Please indicate well location X:

ADDITIONAL INFORMATION

If more than one screen, show locations of each on sketch.