

JACKSON
P 2024
5-10-75

MISSISSIPPI
BOARD OF WATER COMMISSIONERS
416 North State Street
Jackson, Mississippi 39201

WATER WELL DRILLERS LOG

5/10 1975 date well completed
COAST WATER WELL SERVICE INC. firm name
Jackson county well located

LANDOWNER: Floyd Atkinson

description of formations encountered

from to

Rt. 1

Sautter, Miss.
(mailing address)

WELL LOCATION:

sec. 4 T. 8 S. R. 6 E. N. Sautter
(distance) miles (direction) of (nearest town)

WELL PURPOSE: Home
(home, irrigation, municipal, industrial)

WELL COMPLETION DATA:


- (1) diameter (inches) 2"
- (2) total depth (feet) well 300'
- (3) static water level (feet) 15' below top of ground
- (4) casing PVC, 290' (depth)
2" (size) if telescope see back.
- (5) screen 10' (length), 290' (depth to top)
2" (size), PVC (material)
- (6) pump (HP) (yield gpm)
(type power)
- (7) electric log NO (yes or no)
(organization running log)
- (8) how well bottom plugged BWU

description of formations encountered	from	to
top soil	0	4
Red clay	4	10
Grey clay	10	20
Grey sand (c)	20	107
Blue clay	107	129
Grey sand (c)	129	184
Blue clay	184	200
Grey sand (c)	200	300
		Hole

DRILLERS REMARKS:

If well telescopes please sketch and show depths.

GROUND LEVEL

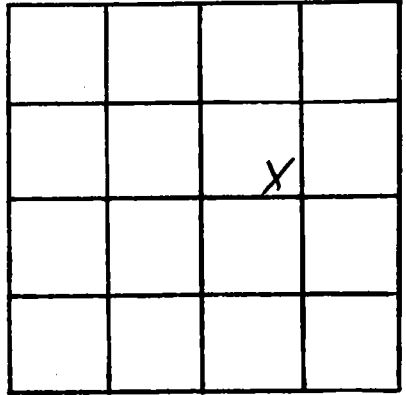

SECTION 4

Please indicate well location X.

ADDITIONAL INFORMATION

If more than one screen, show locations of each on sketch.