

JACKSON
P 2026
5/4/75

MISSISSIPPI
BOARD OF WATER COMMISSIONERS
416 North State Street
Jackson, Mississippi 39201

WATER WELL DRILLERS LOG
COAST WATER WELL SERVICE INC.

5/4 1975 date well completed
130
firm name
Jackson county well located

LANDOWNER: Mary Walker
Fishing Camp
Hautier, Miss.
(mailing address)

WELL LOCATION:
sec. 31 T. 7 R. 6
W 15
no Hautier
miles of (distance) (direction) (nearest town)


WELL PURPOSE: Camp
(home, irrigation, municipal, industrial)

WELL COMPLETION DATA:

- (1) diameter (inches) 2"
(2) total depth (feet) 390
(3) static water level (feet) 35 below top of ground.
(4) casing PVC 380' (material) (depth)
2" (size) if telescope see back.
(5) screen 10' 380' (length) (depth to top)
2" (size) PVC (material)
(6) pump 1 7 1/2 (HP) (yield gpm)
elec. (type power)
(7) electric log NO (yes or no)
(organization running log)
(8) how well bottom plugged BWU

description of formations encountered	from	to
<u>top soil</u>	<u>0</u>	<u>2</u>
<u>gray clay</u>	<u>2</u>	<u>40</u>
<u>Blue Clay</u>	<u>40</u>	<u>63</u>
<u>Sand (C)</u>	<u>63</u>	<u>90</u>
<u>blue clay</u>	<u>90</u>	<u>183</u>
<u>Sand (M)</u>	<u>183</u>	<u>195</u>
<u>Blue Clay</u>	<u>195</u>	<u>210</u>
<u>Sand (M)</u>	<u>210</u>	<u>267</u>
<u>Blue clay</u>	<u>267</u>	<u>280</u>
<u>Sand (M)</u>	<u>280</u>	<u>292</u>
<u>Blue Clay</u>	<u>292</u>	<u>293</u>
<u>Sand (M)</u>	<u>293</u>	<u>318</u>
<u>Blue Clay</u>	<u>318</u>	<u>370</u>
<u>Sand (M)</u>	<u>370</u>	<u>390</u>
		<u>Hole</u>

DRILLERS REMARKS:

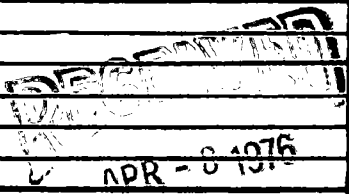

MISS. BD. OF WATER COMMISSIONERS

If well telescopes please sketch and show depths.

GROUND LEVEL

			X

SECTION 31

Please indicate well location X.

ADDITIONAL INFORMATION

If more than one screen, show locations of each on sketch.