

JACKSON
 P 2028
 9-21-75

MISSISSIPPI
 BOARD OF WATER COMMISSIONERS
 416 North State Street
 Jackson, Mississippi 39201
 WATER WELL DRILLERS LOG

13Q

9/21 1975 date well completed
 COAST WATER WELL SERVICE INC. firm name
 Jackson county well located

LANDOWNER: Ed Brown
 2002 Woodlawn
 Moss Point, Miss
 (mailing address)


description of formations encountered	from	to
top soil	0	7
Red + Grey clay	7	21
Dend (F)	21	50
Grey clay	50	64
Dend (C)	64	160
Blue clay	160	236
Dend (C)	236	300

WELL LOCATION:
 sec. 3 T-8 R-7
 0.6 miles (distance) of (direction) of (nearest town)
 in Natchez

WELL PURPOSE: None
 (home, irrigation, municipal, industrial)

- WELL COMPLETION DATA:
- (1) diameter (inches) 2"
 - (2) total depth (feet) well 300'
 - (3) static water level (feet) 38 below top of ground.
 - (4) casing PVC 290' (material) (depth)
 2" (size) if telescope see back.
 - (5) screen 10' 290' (length) (depth to top)
 2" (size) PVC (material)
 - (6) pump 1 (HP) 8 (yield gpm)
 elec. (type power)
 - (7) electric log NO (yes or no)
 (organization running log)
 - (8) how well bottom plugged BWU

DRILLERS REMARKS:

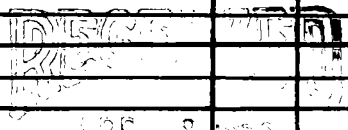

If well telescopes please sketch and show depths.

GROUND LEVEL

		X	

SECTION 3

Please indicate well location X.

ADDITIONAL INFORMATION

If more than one screen, show locations of each on sketch.