

JACKSON
 P 7229
 10-2-75

MISSISSIPPI
 BOARD OF WATER COMMISSIONERS
 416 North State Street
 Jackson, Mississippi 39201

WATER WELL DRILLERS LOG
 COAST WATER WELL SERVICE INC.

$\frac{1}{2}$ 1975 date well completed 138 firm name jackson county well located

LANDOWNER: P. B. Luke
Rt. 2 Box 53
Hautier, Miss.
 (mailing address)

description of formations encountered	from	to
top soil	0	2
blue clay	2	25
sand (c)	25	40
sand (c)	25	40
Blue clay	40	55
sand (c)	55	86
		162

WELL LOCATION:
 sec 2 T 8 R 16
in Hautier
 (distance) miles (direction) of (nearest town)

WELL PURPOSE: Home
 (home, irrigation, municipal, industrial)


- WELL COMPLETION DATA:
- (1) diameter (inches) 2"
 - (2) total depth (feet) 86'
 - (3) static water level (feet) 15 below above top of ground.
 - (4) casing PVC, 76' (material) (depth)
2" (size) if telescope see back.
 - (5) screen 10', 76' (length) (depth to top)
2" (size), PVC (material)
 - (6) pump 1 (HP) 7 (yield gpm)
elec. (type power)
 - (7) electric log No (yes or no)
 (organization running log)
 - (8) how well bottom plugged BWU

DRILLERS REMARKS:

MISS. Bd. of Water Comm.

If well telescopes please sketch and show depths.

GROUND LEVEL

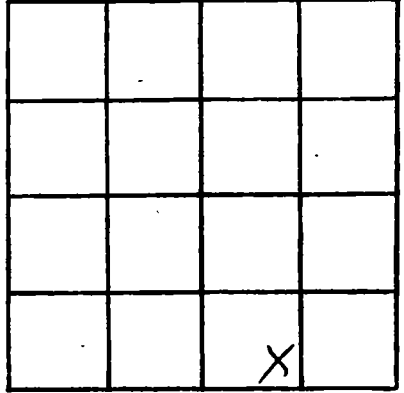

SECTION 31

Please indicate well location X.

ADDITIONAL INFORMATION

If more than one screen, show locations of each on sketch.