

JACKSON  
 P 2031  
 12-23-75

MISSISSIPPI  
 BOARD OF WATER COMMISSIONERS  
 416 North State Street  
 Jackson, Mississippi 39201

WATER WELL DRILLERS LOG

12/23 1975 date well completed  
 Coastal Drilling Co. firm name  
 Rt 1 Box 618 Blount county well located

LANDOWNER: Sidney Shaw

MISS. description of formations encountered	from	to
top soil	1	3
Red Clay	3	20
white sand	20	50
Soft Blue clay	50	85
white sand	85	150
Soft Blue clay	150	170
hard Blue clay	170	230
Coarse water sand	230	260

P.O. Box 67  
 Passapatany Miss  
 (mailing address)

WELL LOCATION:  
 sec. 31 T 27 N R 6 E  
 S W  
 (None) miles N Gautier  
 (distance) (direction) (nearest town)

WELL PURPOSE: home  
 (home, irrigation, municipal, industrial)

WELL COMPLETION DATA:

- (1) diameter (inches) 2'
- (2) total depth (feet) 260'
- (3) static water level (feet) 20 below top of ground.
- (4) casing PVC 250'  
 (material) (depth)
- (5) screen 10' 250'  
 (length) (depth to top)  
 2" PVC  
 (size) (material)
- (6) pump 1/2 (HP) 15 (yield gpm)  
 Elec  
 (type power)
- (7) electric log no  
 (yes or no)

(organization running log)


(8) how well bottom plugged  
 2" backwash valve

DRILLERS REMARKS:  
 none

RECEIVED  
 MAR 1 1976

If well telescopes please sketch and show depths.

GROUND LEVEL

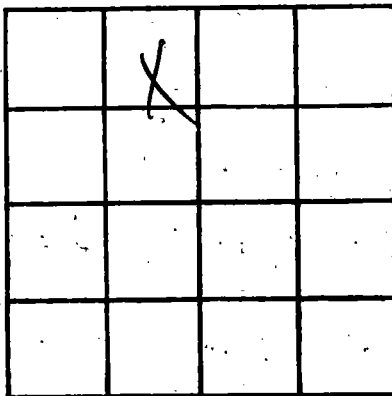

SECTION \_\_\_\_\_

Please indicate well location X.

ADDITIONAL INFORMATION

If more than one screen, show locations of each on sketch.